


Ellis

KANSAS

Section 22 Township 11 Range 17-W

Well No. 13 Johansen

Company Magnolia

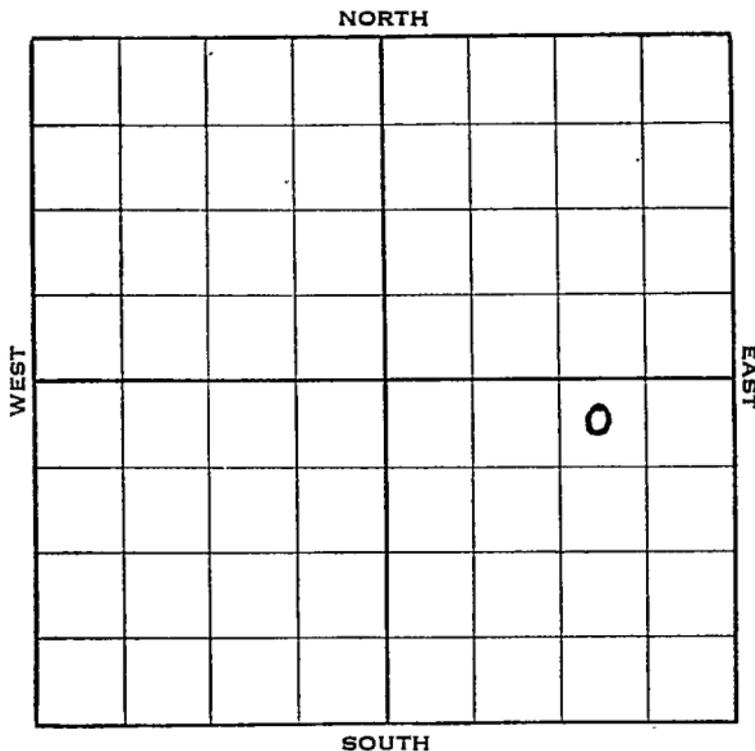

Sec. 22 Twp. 11 R. 17-W

Well No. #13 Johansen Farm  
Magnolia Company


330 Ft. from N. Line

\_\_\_\_\_ Ft. from S. Line

990 Ft. from E. Line

\_\_\_\_\_ Ft. from W. Line

Elev. 1921

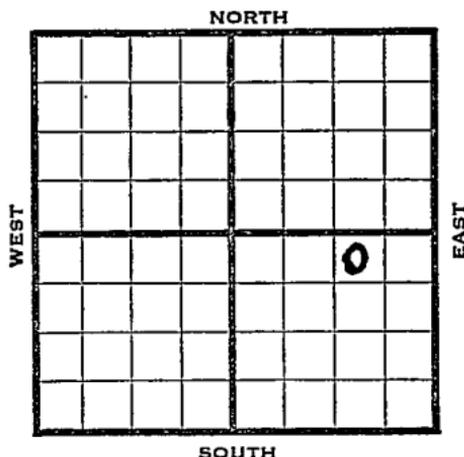

1938	REPORT
4/6	Location
4/15	R. R.
4/22	"
4/29	"
5/6	R U R
5/12	16" @ 59'. Anhy 1112'.
	10" @ 1132'. WOC.
5/20	DrEg. 2620'.
5/27	Arb. 3402-04' T.D. S.O.
	7" @ 3402'. RUST.
6/1	7" @ 3398'. _____
	Arb. 3398'. (Corrected)
	T.D. 3404'.
	Potential 2587' bbls., Nat'l.
	COMPLETED

Map No. 71 Sec. 22 Twp. 11 R. 17W

Well No. 13 Johansen

Magnolia Company

Contractor

**FIRST REPORT**

NW NE SE

330 Ft. from N. Line

\_\_\_\_\_ Ft. from S. Line

990 Ft. from E. Line

\_\_\_\_\_ Ft. from W. Line

**SECTION PLAT**

			0

Location X

Rig up \_\_\_\_\_

Drilling and Remarks:

**RECORD**

Cased \_\_\_\_\_ in., \_\_\_\_\_ ft.

Sand \_\_\_\_\_

Gas \_\_\_\_\_

Oil \_\_\_\_\_

Total Depth \_\_\_\_\_

**PRODUCTION**

1st 24 hrs. Nat. \_\_\_\_\_

1st 24 hrs. after shot \_\_\_\_\_

Gas \_\_\_\_\_ Cu. Ft.

Dry Hole \_\_\_\_\_

Abandoned \_\_\_\_\_

Date

APR 6 - 1938 19

H. D. Hatfield Scout

Map No. 71 Sec. 22 Twp. 11 R. 17W

Well No. 13 Johansen

Magnolia Company

Contractor

**COMPLETED**

**SECTION PLAT**

NW NE SE

330 Ft. from N. Line

\_\_\_\_\_ Ft. from S. Line

990 Ft. from E. Line

\_\_\_\_\_ Ft. from W. Line

			0

Location \_\_\_\_\_

Rig up \_\_\_\_\_

Drilling and Remarks:

*PT 2587*

*Nat*

**RECORD**

Cased 7 in., 3398 ft.

Sand Arb 3398

Gas (Corrected)

Oil \_\_\_\_\_

Total Depth 3404

**PRODUCTION**

1st 24 hrs. Nat. \_\_\_\_\_

1st 24 hrs. after shot \_\_\_\_\_

Gas \_\_\_\_\_ Cu. Ft.

Dry Hole \_\_\_\_\_

Abandoned \_\_\_\_\_

Date

JUN 1 - 1938<sub>19</sub>

E. D. Hatfield Scout