


Section 22 Township 11 Range 17-W

Well No. 10 Johansen

Company Magnolia

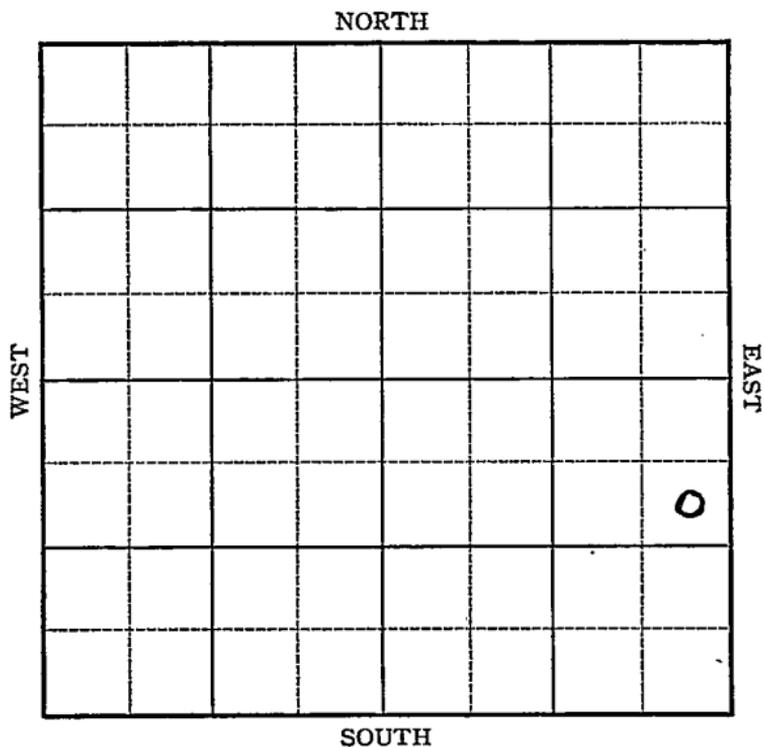

Sec. 22 Twp. 11 R. 17-W


Well No. #10 Johansen Farm
Magnolia Company

990 Ft. from N. Line

_____ Ft. from S. Line

330 Ft. from E. Line

_____ Ft. from W. Line

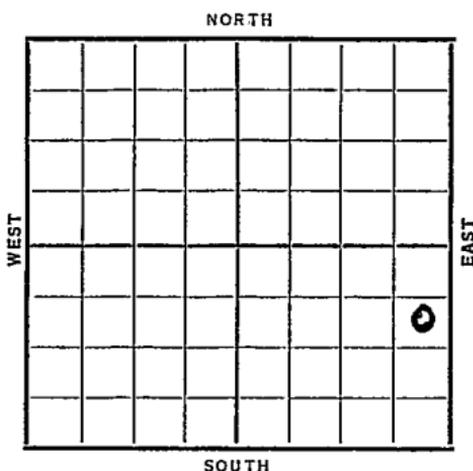

Date	REPORT
1938	
1/19	Location
1/28	B.R.R.
2/4	R.U.R.
2/11	Drlg. 725'.
2/18	Anhy 1107'. 10" @ 1128'.
	Drlg. 1900'.
2/26	Drlg. 3120'.
3/4	Simp. 3358'. Arb. 3368'.
	T.D. 3381'. S.O. 7" @ 3368'.
	RUST.
3/9	7" @ 3368'.
	Arb. 3368'.
	T.D. 3372'.
	Potential 2203 bbls., Nat.
	COMPLETED

Map No. 77 Sec. 22 Twp. 11 R. 17W

Well No. 10 Johansen

Magnolia Company

Contractor

FIRST REPORT

SECTION PLAT

990 SE NE SE
Ft. from N. Line

_____ Ft. from S. Line

330 Ft. from E. Line

_____ Ft. from W. Line

			0

Location X

Rig up _____

Drilling and Remarks:

RECORD

Cased _____ in., _____ ft.

Sand _____

Gas _____

Oil _____

Total Depth _____

PRODUCTION

1st 24 hrs. Nat. _____

1st 24 hrs. after shot _____

Gas _____ Cu. Ft.

Dry Hole _____

Abandoned _____

Date

JAN 19 1938 19

E. D. Hatfield Scout

Ellis KANSAS

Map No. _____ Sec. 22 Twp. 11 R. 17W

Well No. 10 Johansen

Magnolia Company

Contractor

COMPLETED

SECTION PLAT

SE NE SE

990 Ft. from N. Line

_____ Ft. from S. Line

330 Ft. from E. Line

_____ Ft. from W. Line

			0

Location _____

Rig up _____

Drilling and Remarks:

*POT 2203
NOT*

RECORD

Cased 7 in., 3368 ft.

Sand Arb. 3368

Gas _____

Oil _____

Total Depth 3372

PRODUCTION

1st 24 hrs. Nat. _____

1st 24 hrs. after shot _____

Gas _____ Cu. Ft.

Dry Hole _____

Abandoned _____

Date

MAR 9 - 1938

19

H. D. Hatfield Scout