


Section 22 Township 11 Range 17-W

Well No. 4 - Johansen

Company Magnolia

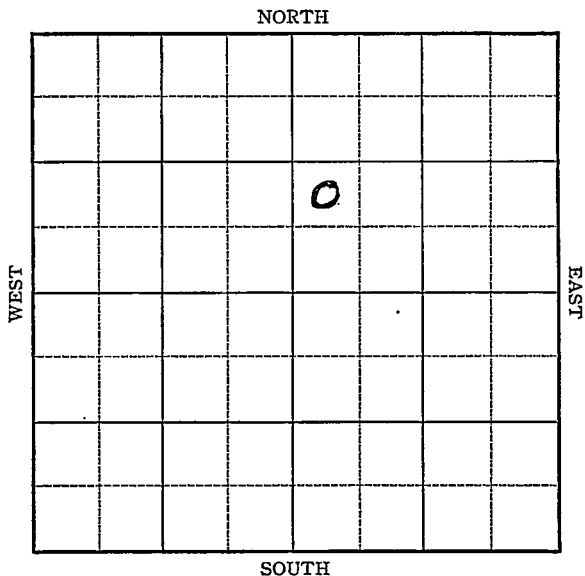

Sec. 22 Twp. 11 R. 17 W

Well No. #4 Johansen Farm  
Magnolia Company


         Ft. from N. Line

990 Ft. from S. Line

         Ft. from E. Line

330 Ft. from W. Line

Elev. 1960

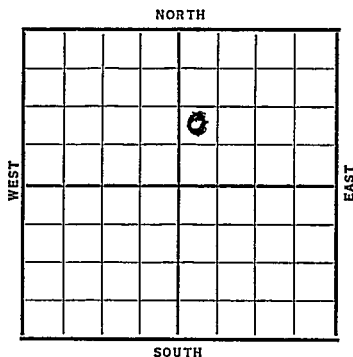

Date	REPORT
1937	
9/1	R. R.
9/10	R. Rig.
9/17	" "
9/24	16" @ 37'. Anhy 1168'.
	10" @ 1189'. WOC.
10/2	DrLg. 2220'.
10/8	Dr&g. 3305'.
10/15	Sil. & 7" @ 3460'. T.D. 3465'.
	Swab 165 B.O. 3 hrs.
10/20	16" @ 37'.
	10" @ 1189'.
	7" @ 3460'.
	Sil. 3460'.
	T.D. 3465'.
	Pot. 2271 bbls. Nat.
	COMPLETED

Ellis KANSAS

Map No. \_\_\_\_\_ Sec. 22 Twp. 11 R. 17WWell No. 4-JohansenMagnolia

Company \_\_\_\_\_

Contractor \_\_\_\_\_

## FIRST REPORT

## SECTION PLAT

		①	

\_\_\_\_\_ Ft. from N. Line

990 Ft. from S. Line

\_\_\_\_\_ Ft. from E. Line

330 Ft. from W. Line

Location \_\_\_\_\_

Rig up \_\_\_\_\_

Drilling and Remarks:

RR

## RECORD

Cased \_\_\_\_\_ in., \_\_\_\_\_ ft.

Sand \_\_\_\_\_

Gas \_\_\_\_\_

Oil \_\_\_\_\_

Total Depth \_\_\_\_\_

## PRODUCTION

1st 24 hrs. Nat. \_\_\_\_\_

1st 24 hrs. after shot \_\_\_\_\_

Gas \_\_\_\_\_ Cu. Ft.

Dry Hole \_\_\_\_\_

Abandoned \_\_\_\_\_

Date

SEP 1 1937 19H. D. Hatfield Scout

ELLIS KANSAS

Map No. \_\_\_\_\_ Sec. 22 Twp. 11 R. 17W

Well No. 4 Johansen

Magnolia Company

Contractor \_\_\_\_\_

**COMPLETED**

**SECTION PLAT**

NW SW NE

\_\_\_\_\_ Ft. from N. Line

990 Ft. from S. Line

\_\_\_\_\_ Ft. from E. Line

330 Ft. from W. Line

.		0	

Location \_\_\_\_\_

Rig up \_\_\_\_\_

Drilling and Remarks:

~~16" - 37~~  
10" RECORD 1189

Cased 7 in., 3460 ft.

Sand 511 3460

Gas \_\_\_\_\_

Oil \_\_\_\_\_

Total Depth 3465

**PRODUCTION**

1st 24 hrs. Nat. \_\_\_\_\_

1st 24 hrs. after shot \_\_\_\_\_

Gas \_\_\_\_\_ Cu. Ft.

Dry Hole \_\_\_\_\_

Abandoned \_\_\_\_\_

POT. 2271  
NAT

Date

OCT 20 1937

H. D. Hatfield Scout