
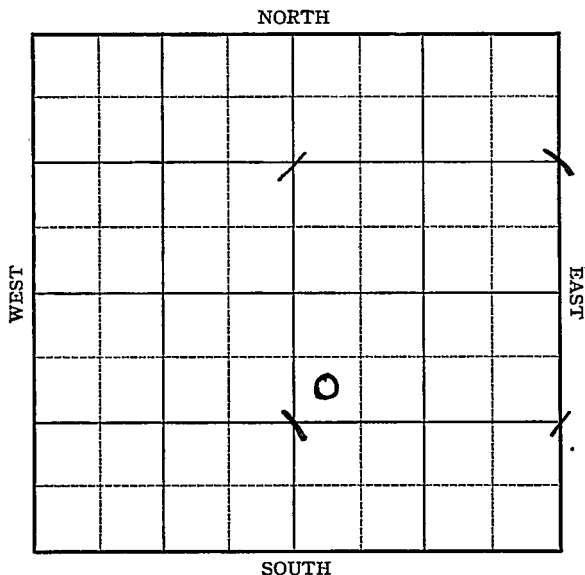


Section 22 Township 11 Range 17-WWell No. 1 - JohansenCompany Magnolia

Sec. 22 Twp. 11 R. 17-WWell No. #1 Johansen FarmMagnolia Company990 Ft. from N. Line Ft. from S. Line Ft. from E. Line330 Ft. from W. Line

Elev. 1973

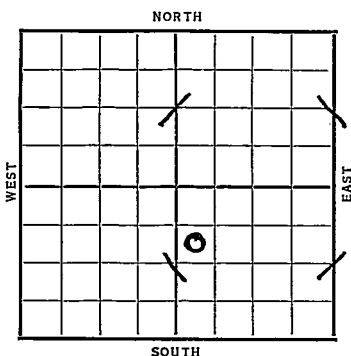


Date	REPORT
1937	
6/9	Location
6/19	Mat.
6/25	15" @ 55'. Drlg. 690'.
7/2	Anhy 1180'. 10" @ 1208'.
	Drlg. 1800'.
7/9	Drlg. 3170'.
7/16	Sil. & 7" @ 3430'. T.D. 3433'
	Drilled plug. Filled up
	1600' in 6 hrs.
7/21	Sil 3430'
	7" @ 3430'
	TD 3436'
	Pump 436/6hrs
	Pot 1570
	Nat.
	COMPLETED

Ellis KANSASMap No. 71 Sec. 22 Twp. 11 R. 17^WWell No. 1-JohansenMagnolia Company

Contractor

FIRST REPORT

SECTION PLAT

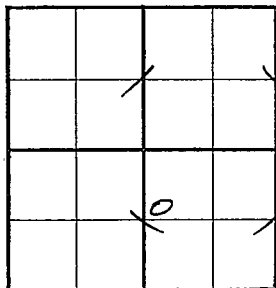990 Ft. from N. Line Ft. from S. Line Ft. from E. Line330 Ft. from W. LineLocation ✓Rig up Drilling and Remarks:

RECORD

Cased in., ft.Sand Gas Oil Total Depth

PRODUCTION

1st 24 hrs. Nat. 1st 24 hrs. after shot Gas Cu. Ft.Dry Hole Abandoned

Date

JUN 9 1937 19 H. D. Hatfield Scout

Map No. 71 Sec. 22 Twp. 11 R. 17 ^WWell No. 1-JohansenMagnolia Company

Contractor

COMPLETED**SECTION PLAT**990 Ft. from N. Line Ft. from S. Line Ft. from E. Line330 Ft. from W. Line

		0	

Location Rig up

Drilling and Remarks:

Pump 436/6 hrs.
POT- 1570'
222

RECORDCased 7 in., 3430 ft.~~Sand~~ 511 3430Gas Oil Total Depth 3436**PRODUCTION**1st 24 hrs. Nat. 1st 24 hrs. after shot Gas Cu. Ft.Dry Hole Abandoned

Date

JUL 21 1937 19 H. D. Hatfield Scout