


Section 22 Township 11 Range 17-W

Well Number 2 - Johansen

Company Empire

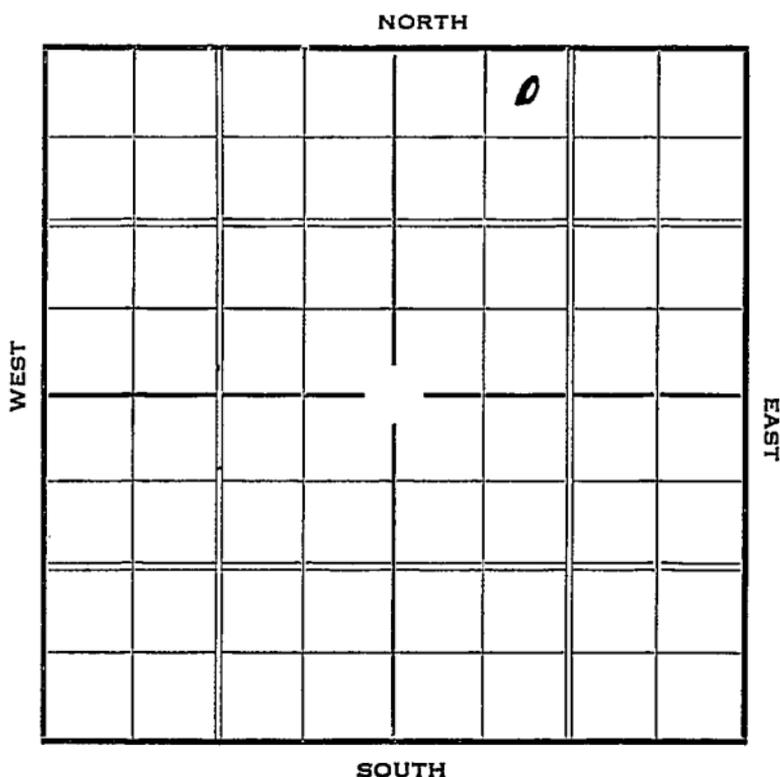

Sec. 22 Twp. 11 R. 17-W

Well No. #2 Johansen Farm  
Empire Company


330 Ft. from N. Line

\_\_\_\_\_ Ft. from S. Line

\_\_\_\_\_ Ft. from E. Line

990 Ft. from W. Line

Elev. 1926

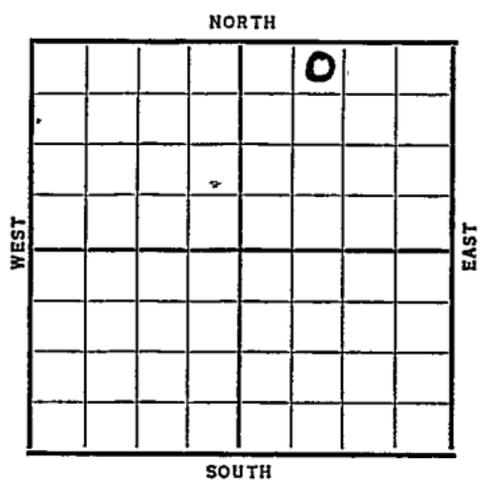

Date	REPORT
1937	
7/14	Location
7/23	B. R. R.
7/30	15" @ 96'. Drlg. 460'.
8/6	Anhy 1135'. 10" @ 1136'. Drlg. 1695'.
8/13	Drlg. 2963'.
8/20	Sil. 3442' & 7". WOC.
8/28	T.D. 3446'. Testing.
9/3	Sil. 3444' (Corrected)
	7" @ 3443'. T.D. 3449'.
	Pumped 135 BO 3 hrs.
	Broke down.
	<b>OVER</b>

1937

9/8

7" @ 3443'.

Sil. 3444' (Corrected)

T.D. 3449'.

Pump 135 bbls. 3 hrs.

Pot. 988 bbls.

COMPLETED

Ellis KANSAS

Map No. \_\_\_\_\_ Sec. 22 Twp. 11 R. 17<sup>W</sup>Well No. 2-JohansenEmpire Company\_\_\_\_\_  
Contractor

## FIRST REPORT

330 Ft. from N. Line

\_\_\_\_\_ Ft. from S. Line

\_\_\_\_\_ Ft. from E. Line

990 Ft. from W. Line

## SECTION PLAT

		0	

Location 

Rig up \_\_\_\_\_

Drilling and Remarks:

## RECORD

Cased \_\_\_\_\_ in., \_\_\_\_\_ ft.

Sand \_\_\_\_\_

Gas \_\_\_\_\_

Oil \_\_\_\_\_

Total Depth \_\_\_\_\_

## PRODUCTION

1st 24 hrs. Nat. \_\_\_\_\_

1st 24 hrs. after shot \_\_\_\_\_

Gas \_\_\_\_\_ Cu. Ft.

Dry Hole \_\_\_\_\_

Abandoned \_\_\_\_\_

Date

JUL 14 1937H. D. Hatfield

Scout

Map No. \_\_\_\_\_ Sec. 22 Twp. 11 R. 17W

Well No. 2-Johansen

Empire Company

Contractor \_\_\_\_\_

**COMPLETED**

**SECTION PLAT**

330 Ft. from N. Line

\_\_\_\_\_ Ft. from S. Line

\_\_\_\_\_ Ft. from E. Line

990 Ft. from W. Line

		0	

Location \_\_\_\_\_

Rig up \_\_\_\_\_

Drilling and Remarks:

P. 135 3 hrs

Prod. 988 bbls

**RECORD**

Cased, 7 in., 344 3/4 ft.

Shoals 3444

Gas (Corrected)

Oil \_\_\_\_\_

Total Depth 3449

**PRODUCTION**

1st 24 hrs. Nat. \_\_\_\_\_

1st 24 hrs. after shot \_\_\_\_\_

Gas \_\_\_\_\_ Cu. Ft.

Dry Hole \_\_\_\_\_

Abandoned \_\_\_\_\_

Date

**SEP 8 1937**

**H. D. Hatfield**