


Ellis

KANSAS

Section 22- Township 11 Range 17-W

Well Number 3 Bemis

Company British American

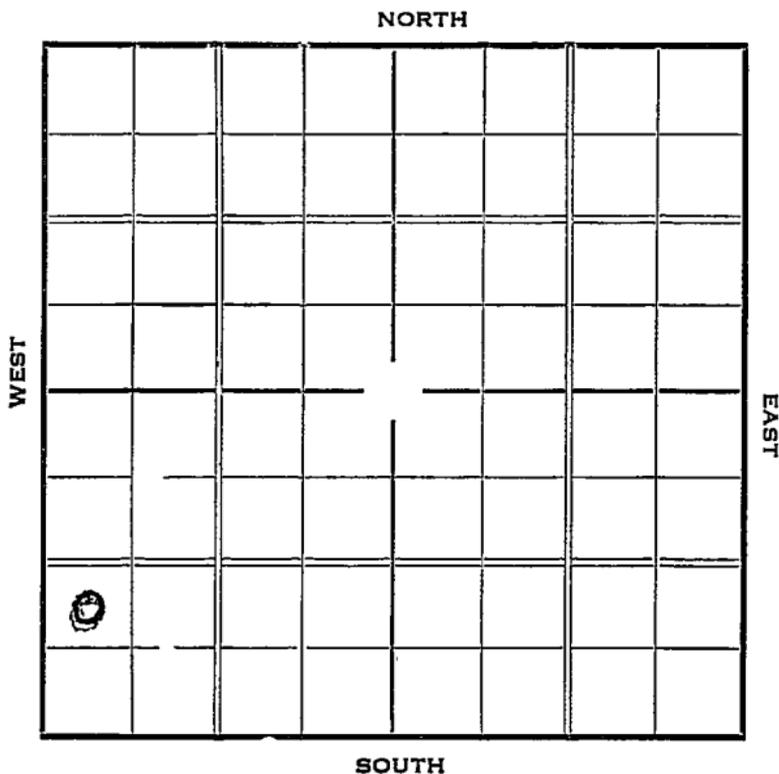

Map No. 71 Sec. 22 Twp. 11 R. 17W

Well No. 3 Benis

British American Company

Contractor

SECTION PLAT

0			

_____ Ft. from N. Line

990 Ft. from S. Line

_____ Ft. from E. Line

1380 Ft. from W. Line

FIRST REPORT

Location ✓

Rig up _____

Drilling and Remarks:

RECORD

Cased _____ in., _____ ft.

Sand _____

Gas _____

Oil _____

Total Depth _____

PRODUCTION

1st 24 hrs. Nat. _____

1st 24 hrs. after shot _____

Gas _____ Cu. Ft.

Dry Hole _____

Abandoned _____

Date

DEC 22 1936

19

S. J. LEWIS Scout

Map No. _____ Sec. 22 Twp. 11 R. 17WWell No. 3 BemisBritish American Company

Contractor

SECTION PLAT

0			

_____ Ft. from N. Line

990 Ft. from S. Line

_____ Ft. from E. Line

330 Ft. from W. Line

COMPLETED

Location _____

Rig up _____

Drilling and Remarks:

Si 63418Potential2309 natural

RECORD

Cased _____ in., _____ ft.

Sand _____

Gas _____

Oil _____

Total Depth 3426

PRODUCTION

1st 24 hrs. Nat. _____

1st 24 hrs. after shot _____

Gas _____ Cu. Ft.

Dry Hole _____

Abandoned _____

Date

FEB 10 1937

19

S. J. LEWIS Scout