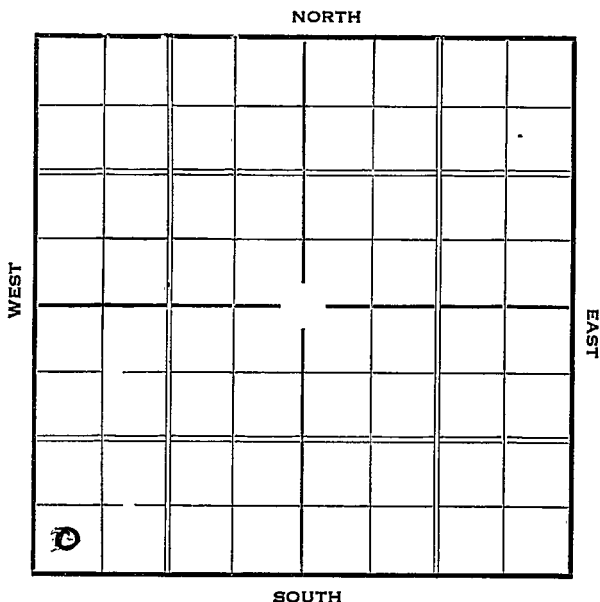
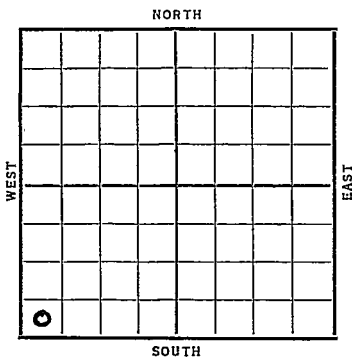


Section 22 Township 11 Range 17-WWell Number 4 BemisCompany British American

Sec. 22 Twp. 11x R. 17WWell No. 4 Bemis FarmBritish American Company       Ft. from N. Line330 Ft. from S. Line       Ft. from E. Line330 Ft. from W. Line*Elv. 1987*Date  
1937

## REPORT

1/27

Rig

2/4

"

2/11

Surface hole

2/19

Anhydrate 1196'

10" @ 1204' Drlg.

2/26

Drlg. 3169'

3/4

Sil. 3453'. 7" @ 3453'.

T.D. 3466'. WOC

3/11

T.D. 3476'. Hole full oil.

3/17

Sil. 3468'. Corrected.

T. D. 3476'.

Pump 2929 natural.

COMPLETED

Map No. 71 Sec. 22 Twp. 11 R. 17W

Well No. 4 Bemis

British American Company

Contractor

**SECTION PLAT**

|  |  |  |  |
|--|--|--|--|
|  |  |  |  |
|  |  |  |  |
|  |  |  |  |
|  |  |  |  |

\_\_\_\_\_ Ft. from N. Line

330 Ft. from S. Line

\_\_\_\_\_ Ft. from E. Line

330 Ft. from W. Line

**FIRST REPORT**

Location \_\_\_\_\_

Rig up \_\_\_\_\_

Drilling and Remarks:

*Rig*

**RECORD**

Cased \_\_\_\_\_ in., \_\_\_\_\_ ft.

Sand \_\_\_\_\_

Gas \_\_\_\_\_

Oil \_\_\_\_\_

Total Depth \_\_\_\_\_

**PRODUCTION**

1st 24 hrs. Nat. \_\_\_\_\_

1st 24 hrs. after shot \_\_\_\_\_

Gas \_\_\_\_\_ Cu. Ft.

Dry Hole \_\_\_\_\_

Abandoned \_\_\_\_\_

Date

JAN 27 1937

S. J LEWIS

Scout

KANSAS

Ellis

Map No. 71 Sec. 22 Twp. 11 R. 17WWell No. 4 BemisBritish-American Company

Contractor

## SECTION PLAT

|  |  |  |  |
|--|--|--|--|
|  |  |  |  |
|  |  |  |  |
|  |  |  |  |
|  |  |  |  |

       Ft. from N. Line330 Ft. from S. Line       Ft. from E. Line330 Ft. from W. Line

COMPLETED

Location                                 Rig up                                 

Drilling and Remarks:

Sec 3468  
correctedPump 2949  
natural

## RECORD

Cased            in.,            ft.Sand                                 Gas                                 Oil                                 Total Depth 3476

## PRODUCTION

1st 24 hrs. Nat.                                 1st 24 hrs. after shot                                 Gas                                  Cu. Ft.\* Dry Hole                                 Abandoned                                 

Date

MAR 17 1937

19

S. J. LEWIS Scout