TYPE

SIDE ONE

AFFIDAVIT OF COMPLETION FORM

ACO-1 WELL HISTORY

31-11-22W

Two (2) copies of this form shall be filed with the Kansas Corporation Commission, 200 Colorado Derby Building, Wichita, Kansas 67202, within thirty (30) days after the completion of a well, regardless of how the well was completed.

Attach separate letter of request if the information is to be held confidential. If confidential, only file one copy. Information on Side One will be of public record and Side Two will then be held confidential.

Applications must be made on dual completion, commingling, salt water disposal, injection and temporarily abandoned wells.

Attach one copy only wireline logs (i.e. electrical log, sonic log, gamma ray neutron log, etc.). (Rules 82-2-105 & 82-2-125) KCC# (316) 263-3238.

LICENSE # 5211 EXPIRATION DATE 6-30-83

OPERATOR Leith Operations API NO. 15-195-21,063

ADDRESS 802 Union Center COUNTY Trego

Wichita, KS 67202 FIELD

** CONTACT PERSON C. E. Leith PROD. FORMATION D&A

PHONE ~~316/265-3491~~

PURCHASER LEASE ALBIN

ADDRESS WELL NO. 2

WELL LOCATION NW SE NW

DRILLING CONTRACTOR Abercrombie Drilling, Inc.

990 Ft. from East Line and

ADDRESS 801 Union Center

990 Ft. from South Line of

Wichita, KS 67202


the NW (Qtr.) SEC 31 TWP 11S RGE 22W.

PLUGGING CONTRACTOR ADDRESS Abercrombie Drilling, Inc.

801 Union Center

Wichita, KS 67202

WELL PLAT

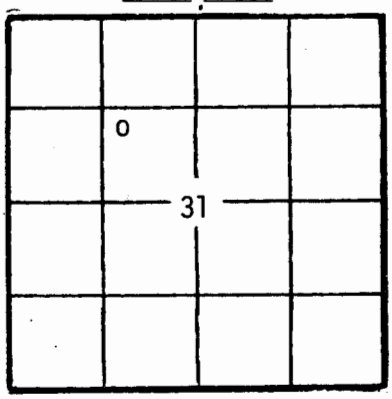

(Office Use Only)

KCC ✓

KGS

SWD/REP

PLG.

TOTAL DEPTH 4060' PBTD

SPUD DATE 8/19/82 DATE COMPLETED 8/28/82

ELEV: GR 2335 DF KB 2340

DRILLED WITH (CABLE) (ROTARY) (AIR) TOOLS.

DOCKET NO. OF DISPOSAL OR REPRESSURING WELL BEING USED TO DISPOSE OF WATER FROM THIS LEASE .

Amount of surface pipe set and cemented 323.36' DV Tool Used? No .

THIS AFFIDAVIT APPLIES TO: (Circle ONE) - Oil, Gas, Shut-in Gas, (Dry,) Disposal, Injection, Temporarily Abandoned, OWWO. Other .

ALL REQUIREMENTS OF THE STATUTES, RULES AND REGULATIONS PROMULGATED TO REGULATE THE OIL AND GAS INDUSTRY HAVE BEEN FULLY COMPLIED WITH.

State Geological Survey WICHITA, BRANCH

AFFIDAVIT

C. E. Leith , being of lawful age, hereby certifies that:

I am the Affiant, and I am familiar with the contents of the foregoing Affidavit. The statements and allegations contained therein are true and correct.

(Name)

P(

SIDE TWO

ACO-1 WELL HISTORY

OPERATOR Leith Operations LEASE ALBIN #2 SEC. 31 TWP. 11S RGE. 22W

FILL IN WELL LOG AS REQUIRED:

Show all important zones of porosity and contents thereof; cored intervals, and all drill-stem tests, including depth interval tested, cushion used, time tool open, flowing and shut-in pressures, and recoveries.

SHOW GEOLOGICAL MARKERS, LOGS RUN, OR OTHER DESCRIPTIVE INFORMATION.

FORMATION DESCRIPTION, CONTENTS, ETC.	TOP	BOTTOM	NAME	DEPTH
Clay, Sand & Rock	0	135	SAMPLE TOPS:	
Shale & Rock	135	332		
Sand & Shale	332	1745	Anhydrite	1774'
Shale	1745	1773	B/Anhyd.	1815'
Anhydrite	1773	1815	Heebner	3550
Shale	1815	2413	Lansing	3582
Lime & Shale	2413	3610	Swope	3807
Lime	3610	3660	Hertha	3856
Lime & Shale	3660	3736	Marmaton	3910
Lime	3736	3777	Arbuckle	4005
Lime & Shale	3777	3885		
Lime	3885	4060		
Rotary Total Depth	4060			
			DRILL STEM TEST NO. 4 MisRun	
DRILL STEM TEST No. 1			DRILL STEM TEST NO. 5	
3555-80			30" 60" 30" 60" Weak Blow - Died	
30" 30" 30" 30"			Rec. 10' SOCM IFP 46-49 FFP 58-58	
Weak blow - died - Rec. 5' drlg. mud			ISIP 1000# FSIP 954#	
IFP 35#-35# FFP 35# - 35#			IHP 2076# FHP 2065#	
ISIP 35# FSIP 35#				
IHP 1734# FHP 1711#				
DRILL STEM TEST NO. 2				
3576-3610				
30" 30" 30" 30"				
Weak blow - died Rec. 268'Drilling Mud & Wtr.				
IFP 46-104 FFP 127-174#				
ISIP 760# FSIP 737#				
IHP 1893# FHP 1870#				
DRILL STEM TEST NO. 3				
3753-77' Weak blow - Died - Rec. 25' Drlg. Mud				
30" 30" 30" 30" IFP 35#-35# FFP 46#-46# ISIP 1035#			FSIP 1000#	

Report of all strings set — surface, intermediate, production, etc. CASING RECORD (New) or (Used)

Purpose of string	Size hole drilled	Size casing set (in O.D.)	Weight lbs/ft.	Setting depth	Type cement	Sacks	Type and percent additives
Surface	12¼"	8 5/8"	20#	323.36'	Common	225	2% gel, 3% c.c.

LINER RECORD			PERFORATION RECORD		
Top, ft.	Bottom, ft.	Sacks cement	Shots per ft.	Size & type	Depth interval
TUBING RECORD					
Size	Setting depth	Packer set at			