

KANSAS

Ellis

Section 23 Township 11 Range 18W

Well No. 1 Lynn "C"

Company Derby & Appleman

Burnett

NORTH

							o

WEST

EAST

SOUTH

Sec. 23 Twp. 11 R. 18W

Well No. 1 Lynn "C" Farm _____

_____ Derby & Appleman _____ Company


Burnett Pool Peel Drlg. - Contr. _____

990 Ft. from N. Line

_____ Ft. from S. Line

330 Ft. from E. Line

_____ Ft. from W. Line

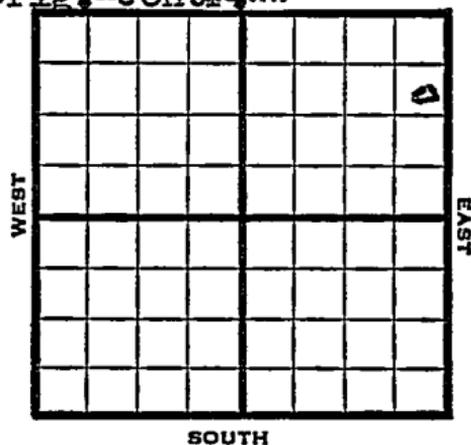

SE NE NE

1949 Elev. 2081' DF^R REPORT

9/28 Loc.

10/5 RUR

10/12 "

10/19 8" @ 1355'

Drig 3175'

10/26 Lansing 3309'

Arbuckle 3629'

TD 3031'

5" @ 3630'

11/1 TD 3634'

900' in 13 hrs.

11/8 500 acid

11/23 TD 3634'

Arb. 3629'

5" @ 3630'

500 acid

Pump 486 Oil Pot

36° Gr.

Comp

COMPLETED

Map No. _____ Sec. 23 Twp. 11 R. 18W

Well No. 1 Lynn "C"

Derby & Appleman Company

Peel Drlg. Contractor

SE NE NE

FIRST REPORT
SECTION PLAT

990 Ft. from N. Line

_____ Ft. from S. Line

330 Ft. from E. Line

_____ Ft. from W. Line

Ellis County

Location X

Rig up _____

Drilling and Remarks:

RECORD

Cased _____ in., _____ ft.

Sand _____

Gas _____

Oil _____

Total Depth _____

PRODUCTION

1st 24 hrs. Nat. _____

1st 24 hrs. after shot _____

Gas _____ Cu. Ft.

Dry Hole _____

Abandoned _____

Date

SEP 28 1949 19

S. J. LEWIS Scout

Kansas

Map No. _____ Sec. 23 Twp. 11 R. 18WWell No. 1 Lynn "C"

Derby & Appleman _____ Company

COMPLETE

Contractor

SE NE NE

E1.2087
SECTION PLAT990 Ft. from N. Line

_____ Ft. from S. Line

330 Ft. from E. Line

_____ Ft. from W. Line

			o

Ellis County

Location _____

Rig up _____

Drilling and Remarks:

*Per 83629**5" 83638**5000 cu ft**Per 48616 BT**36 1/2*

RECORD

Cased _____ in., _____ ft.

Sand _____

Gas _____

Oil _____

Total Depth: *2624*

PRODUCTION

1st 24 hrs. Nat. _____

1st 24 hrs. after shot _____

Gas _____ Cu. Ft.

Dry Hole _____

Abandoned _____

Date

NOV 23 1949

19

S. J. LEWIS

Scout