


Section 23 Township 11 Range 19W

Well No. #4 C. E. Vine "A"

Company Continental Oil

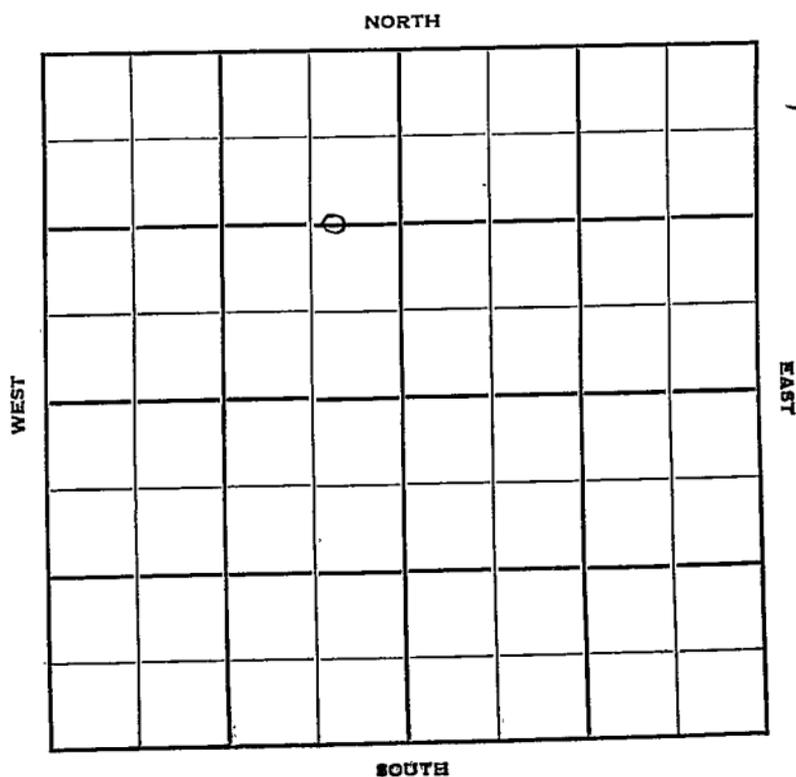

Ellis

FORM 252-B
10M 11-50 PETROL

KANSAS
19 W ✓

Sec. 23 Twp. 11

Well No. # 4 C. E. Vine "A" Farm

Continental Oil Company

Contractor


NE Soloman Pool

1320 Ft. from N. Line

Ft. from S. Line

Ft. from E. Line

2200 Ft. from W. Line

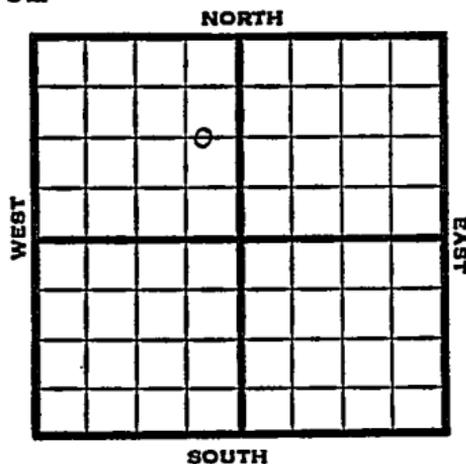

C E L E $\frac{1}{2}$ NW

1951 Elev. 1960' REPORT

8/15 Spud 8-10-51
13" @ 125' 8" @ 1285'
Anhy 1260' WOC

9/19 Spud 8-10-51
Oil well TD 3490' 13" @ 125'
8" @ 1285' Anhy 1260' Top 2896'
Heeb 3121' Tor. 3144' KC 3161'
Cong. 3414' Simp. 3448'
Arb. 3463-67' 5 $\frac{1}{2}$ " @ 3464'
CO to 3490' S/40 BOPH 16 hr.
Comp. 3cho pot. 3000 BOPD

COMPLETED

County Ellis State Kansas

Sec. 23 (Blk. 11) (Sur. Rge.) 19W Map No.

Operator Continental Oil

Well No. 4 Farm C. E. Vine "A"

Elev. Location C E L E $\frac{1}{2}$ NW

1320 Ft. From N Line NW
2200 Ft. From W Line Quarter

1st. Report AUG 15 1951

Completion _____

Remarks _____

Spudding Date 8-10-51

Drilg. Data NE Solomon Pool

13" @ 125 8" @ 1285 Anhy 1260 WOC

~~Twp. Pool~~
~~Co. No. Face~~
O. W. P. B.

S-513-B

County Ellis Elev. _____
 Sec. 23 Twp. 11 Rge. 19W
 Company Continental Oil Co.
 Farm Name C. E. Vine "A" No. 1

TOPS	DEPTH	LOG	DATUM
Anh.			
Tp.	2900		
H.	3121		
Tr.	3171		
Dg.			
B.L.			
L.	3161		
K.C.			
B.K.C.			
Ce.			
C.	3474		
M.			
M.			
K.			
Mz.			
Mq.			
V.			
S.	3448		
S.			
A.	3463		
R.			
Pf.			
G.	OTD 3490		
T.D.	3490		

Loc. in Sec. _____
C E/2 E/2 NW
(O.W.P.B.)
 Geol. O. W. P. B.
 Contr. _____
 Pool _____
NE Solomon

COMPLETE
FIRST REPORT
 AUG 6 1958

Date Comm. OLD INFO: Tops. 5" @ 3464.
NEW INFO: CO 3115, 8/3085-89 2000A, Swb
30 BO-7 8 BW 9 hrs, perf 12/3032-38no test
PB 3063, 1000A, Swb 18 1/2 BO & 19 BW 4 hrs,
CO 3130, perf 20/2922-32, test dry, PB 2957,
2000A, Swb 13 BO & 10 BW 6 hrs, CO 3122, Swb
4 BOPH & 2 BWPH 2 hrs, POP, P 50 BO & 1 1/4 BW
24 hrs (30° Corr) from top perfs overall
2922-3089, TD 3490, PB 3122, COMPLETE.