

Ellis

KANSAS

Sec. 23 Twp. 11 R. 19 W

Well No. # 1 Devine Farm

Continental Oil Company

Contractor

Soloman Pool


440 Ft. from N. Line

Ft. from S. Line

Ft. from E. Line

330 Ft. from W. Line

NW NW NE

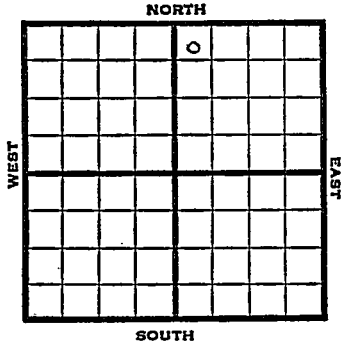

1951

Elev. 1933' REPORT

5/16
7/11

Location
 Spud 5-30-51
 Oil Well TD 3464
 13" @ 127 8" @ 1308
 Anhy 1268 Heeb. 3108
 Lans. 3149 Arb. 3446
 TD 3451 5" @ 3447
 DD 3457 S/41 boph DD 3464
 S/41 boph Comp. draw down pot. 1919
 bopd

COMPLETED

