

Ellis County

Burnett Pool


FORM 51 IOM 12-46*PETROL

KANSAS

Section 23 Township 11 Range 18W

Well No. 1 Lynn "B"

Company Nate Appleman

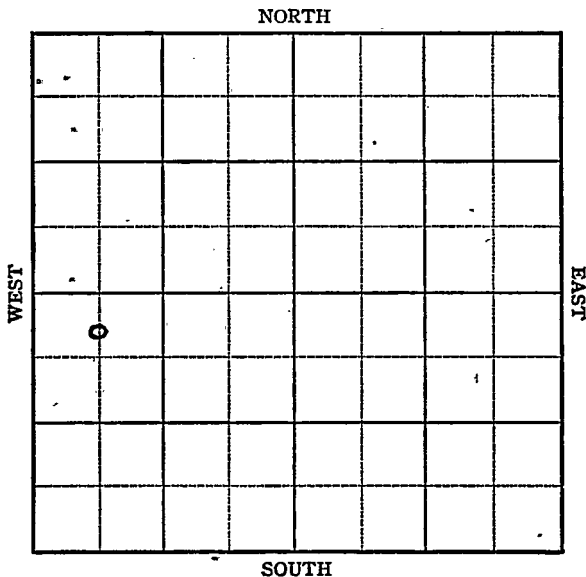

~~13~~
12

Sec. 23 Twp. 11 R. 18-W

Well No. #1 Lynn "B" Farm

Nate Appleman Company


Burnett Pool

330 Ft. from N. Line

 Ft. from S. Line

 Ft. from E. Line

660 Ft. from W. Line

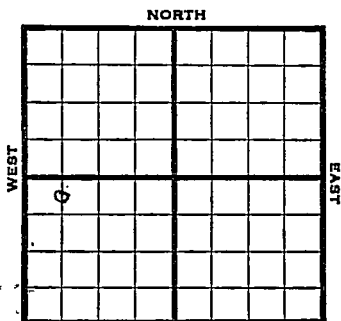

C N L NW SW Elev. 2091'

REPORT

1947

3/5 Location

3/11 Anhy 1327'
8" @ 1335
WOC

3/186 Drlg 2675'

3/25 Lans 3326
Drlg 3529'

4/2 Simp 3618'
Arb 3629-34
TD 3634
5" @ 3630'
RUST

4/9 Swb 40 bbls oil PH 6 hrs

4/15 " " "

4/23 " " "

4/29 500 Acid

5/7 Arb 3629
5" @ 3630
500 Acid
Pump 626 Pot

~~TD 3634~~ TD 3634

COMPLETED


Kansas KANSAS

Burnett Pool

Map No. 71 Sec. 23 Twp. 11 R. 18WWell No. 1 Lynn "B"Nate Appleman CompanyFIRST REPORT Contractor

C N L NW SW

SECTION PLAT

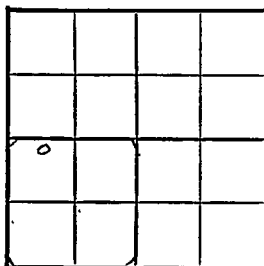330 Ft. from N. Line Ft. from S. Line Ft. from E. Line660 Ft. from W. LineEllis CountyLocation XRig up

Drilling and Remarks:

RECORD

Cased in., ft.Sand Gas Oil Total Depth

PRODUCTION

1st 24 hrs. Nat. 1st 24 hrs. after shot Gas Cu. Ft.Dry Hole Abandoned

Date

MAR 5 1947 19S. J. LEWIS Scout

Kansas

KANSAS

Map No. K 71 Sec. 23 Twp. 11 R. 18WWell No. 1 Lynn "B"


Nate Appleman

Company

COMPLETE

Contractor

C N L NW SW

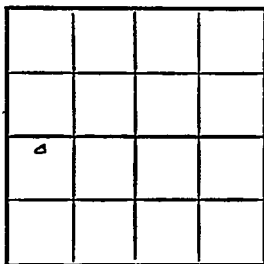E. 209/
SECTION PLAT330 Ft. from N. Line Ft. from S. Line Ft. from E. Line660 Ft. from W. Line

Ellis County

Location

Rig up

Drilling and Remarks:

RT 3629
5' 03630
50000000
Pump 626 BT

300000

RECORD

Cased _____ in., _____ ft.

Sand _____

Gas _____

Oil _____

Total Depth 3634

PRODUCTION

1st 24 hrs. Nat. _____

1st 24 hrs. after shot _____

Gas _____ Cu. Ft.

Dry Hole _____

Abandoned _____

Date

MAY 7 1947 19

S. I. LEWIS Scout