


Section 23 Township 11 Range 19W

Well No. #7 Devine

Company Continental

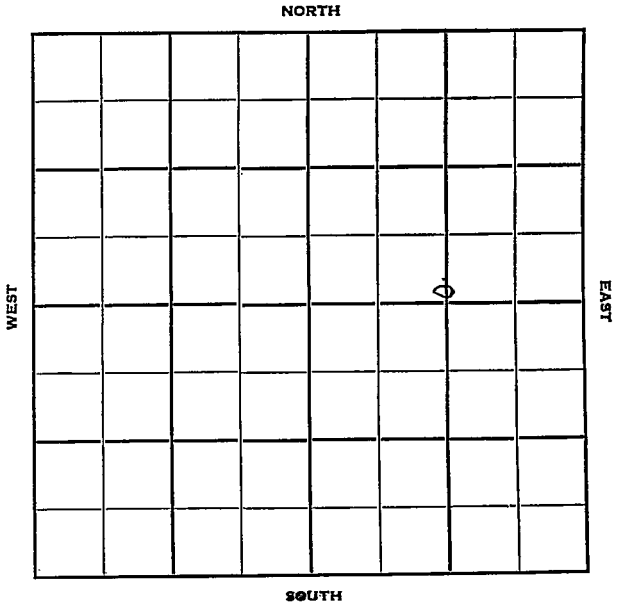

Sec. 23 Twp. 11 R. 19W

Well No. #7 Devine Farm

Continental Company

Contractor


~~220'~~ Ft. from N. Line

220' Ft. from S. Line

1320' Ft. from E. Line

Ft. from W. Line

CSL $5\frac{1}{2}$ NE
C. N. L. $N\frac{1}{2}$ NE Twin

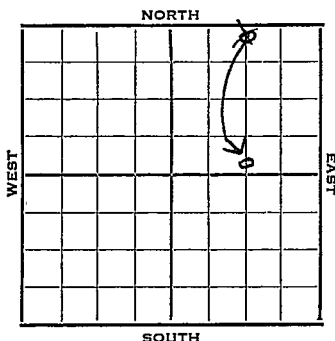

1951 Elev. 2063' REPORT

12/19 Spud 12-13-51
13 @ 204
Drlg. 2490

1952
1/2 D&A TD 3706
13" @ 204
Heeb. 3268 Lans. 3310
Cong. 3574
TD 3706

ABANDONED


County Ellis State Kansas

Sec. 23 (Blk. Twp.) 11 (Sur. Rge.) 19W Map No.

Operator Continental

Well No. 7 Farm Devine

Elev. _____ Location CNE $N\frac{3}{8}$ NE (twins)

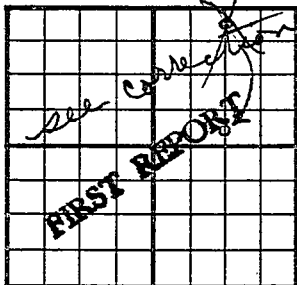

220 Ft. From N Line NE

1320 Ft. From E- Line Quarter

1st. Report DEC 1 9 1951

Completion _____

Remarks _____

Spudding Date 12-13-51

Drlg. Data Saloman

13' @ 204 Drlg. 2490

J. E. TYRA

Map No. _____ Sec. 23 Twp. 11 R. 19WWell No. 7 Devine

Continental _____ Company

CORRECTION

Contractor _____


C S L S $\frac{1}{2}$ NE

SECTION PLAT

_____ Ft. from N. Line

220 Ft. from S. Line1320 Ft. from E. Line

_____ Ft. from W. Line

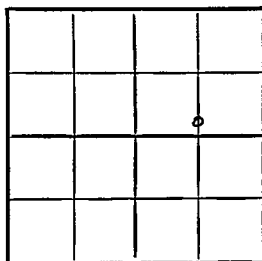

Ellis County

Location _____

Rig up _____

Drilling and Remarks:

Reported

C N L N $\frac{1}{2}$ NE

RECORD

Cased _____ in., _____ ft.

Sand _____

Gas _____

Oil _____

Total Depth _____

PRODUCTION

1st 24 hrs. Nat. _____

1st 24 hrs. after shot _____

Gas _____ Cu. Ft.

Dry Hole _____

Abandoned _____

Date

DEC 1 9 1951 19J. E. TYRA Scout


County Ellis State Kansas

Sec. 23 (Blk. 11) (Sur. 19W) (Twp.) (Rge.) Map No.

Operator Continental Oil

Well No. 7 Farm Devine

Elev. 2063 Location C S L S $\frac{1}{2}$ NE

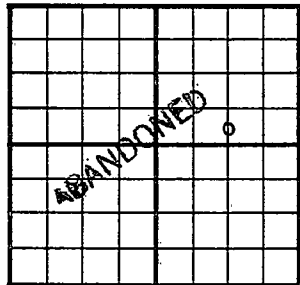

220 Ft. From S Line NE

1320 Ft. From E Line Quarter

Ist. Report

Completion JAN 2 1952

Remarks Solomon Pool

Spudding Date 12-13-51

Drlg. Data D & A TD 3706

13" @ 204 Heeb. 3268 Lans. 3310

Cong. 3574 TD 3706

D & A

J. E. TYRA