


Section 23 Township 11 Range 19W

Well No. #4 R. P. Devine

Company Continental Oil

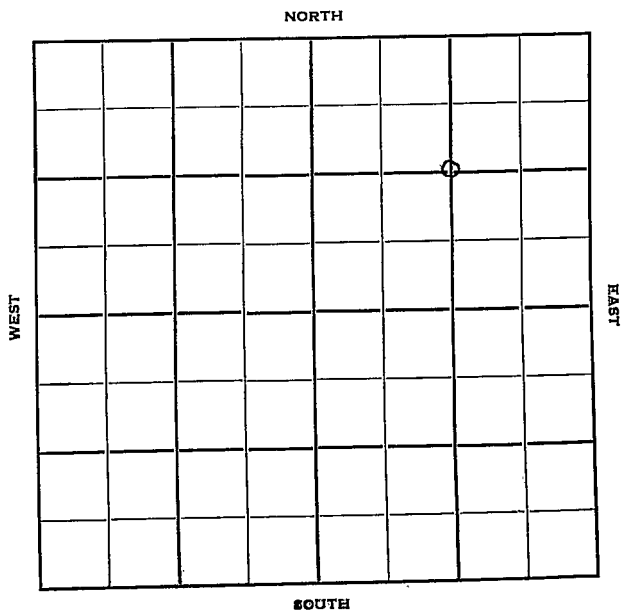

Ellis

KANSAS ✓

Sec. 23 Twp. 11 R. 19 W

Well No. # 4 R. P. Devine Farm

Continental Oil Company

Anschutz Drlg. Contractor

NE Solomon Pool


1320 Ft. from N. Line

\_\_\_\_\_ Ft. from S. Line

1320 Ft. from E. Line

\_\_\_\_\_ Ft. from W. Line

C NE/4

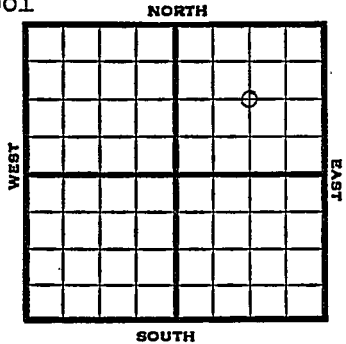

1951

Elev. 1935' REPORT

8/15

Spud 8-12-51  
13" @ 124 WOC

9/19

Spud 8-12-51  
Oil well TD 3472' 13" @ 124  
Anhy 1270' 8" @ 1279' Heeb 3123'  
KC 3163' Cong. 3403' Arb. 3461'  
TD 3463' 5" @ 3462' DD 3472'  
S/108 BOPD P/144 BOPD  
Comp. deptho. pot. 3000 BOPD

COMPLETED



County Ellis State Kansas

Sec. 23 (<sup>Bk.</sup>Twp.) 11 (<sup>Sur.</sup>Rge.) 19W Map No.

Operator Continental Oil

Well No. 4 Farm R. P. Devine

Elev. 1935 Location C NE/4


1320 Ft. From N Line NE

1320 Ft. From E Line Quarter

1st. Report

Completion SEP 19 1951

Remarks NE Solomon Pool

Anschutz Drlg. - Contr.

Spudding Date 8-12-51

Drlg. Data Oil well TD 3472

13" @ 124 Anhy 1270 8" @ 1279

Heeb. 3123 KC 3163 Cong. 3403

Arb. 3461 TD 3463 5" @ 3462

DD 3472 S/ 108 bopd P/ 144 bopd

Comp. deptho. pot. 3000 bopd