

Section 23 Township 11 Range 19 W

Well No. # 1 Vine

Company Gulf Oil

NORTH

WEST

EAST

			0				

SOUTH

M

Ellis

KANSAS

Sec. 23 Twp. 11 R. 19W

Well No. #1 Vine Farm

Gulf Oil Company

Contractor

Soloman


330 Ft. from N. Line

_____ Ft. from S. Line

330 Ft. from E. Line

_____ Ft. from W. Line

NE NE SW

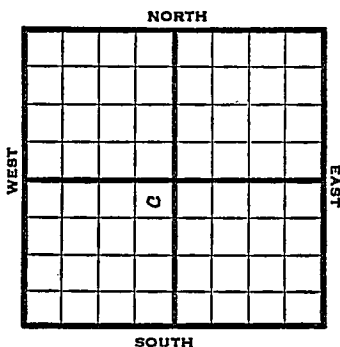

1951 Elev. 2015' REPORT

11/7 Location

1952
1/30

Spud 11-28-51
 Oil Well TD 3531
 Anhy 1323
 8" @ 1336' Heeb. 3190
 Lans. 3228 Arb. 3519-26
 5" @ 3521 CO to 3526
 S/ 83 B0 4 hr. DD 3531
 S/ 116 B0 2 hr. 500 A S/ 75 BOPH
 Comp. 3000 BOPD

COMPLETED


County **ELLIS** State **Kansas**

Sec. **23** (Blk. Twp.) **11** (Sur. Rge.) **19W** Map No.

Operator **Gulf Oil**

Well No. **I** Farm **Vine**

Elev. Location **NE NE SW**

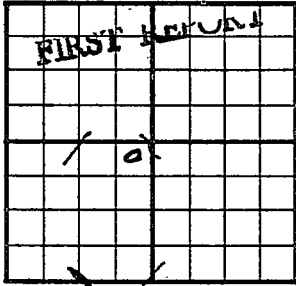

330 Ft. From **N** Line **SW**

330 Ft. From **E** Line Quarter

Ist. Report **NOV 7 1951**

Completion

Remarks

Spudding Date

Drlg. Data **Solomon**

Location

J. E. TYRA

County Ellis State Kansas

Sec. 23 (Blk. 11) (Sur. 19W) Map No.

Operator Gulf Oil

Well No. 1 Farm Vine

Elev. 2015 Location NE NE SW

COMPLETE

330 Ft. From N Line SW

330 Ft. From E Line Quarter

Ist. Report

Completion JAN 30 1952

Remarks Soloman Pool

Spudding Date 11-28-51

Drlg. Data Oil well TD 3531

Anhy 1323 8" @ 1336 Heeb. 3190

Lans. 3228 Arb. 3519-26 5" @ 3521

CO to 3526 S/ 83 bo 4 hr. DD 3531

S/ 116 bo 2 hr. 500 A S/ 75 boph

Comp. 3000 bopd

J. G. McGEHEE