

Section 23 Township 11 Range 19-W

Well No. #1 Vine

Company Brooks Pierce

NORTH

| | | | | | | | |
|---|--|--|--|--|--|--|--|
| | | | | | | | |
| | | | | | | | |
| | | | | | | | |
| | | | | | | | |
| 0 | | | | | | | |
| | | | | | | | |
| | | | | | | | |
| | | | | | | | |

~~13~~
12

WEST

EAST

SOUTH

Ellis
11

KANSAS 19W
R. ✓

Sec. 23 Twp.

Well No. #1 Vine Farm

Brooks Pierce Company

Brooks Pierce - Contr. Contractor
Semi-Wildcat


330' Ft. from N. Line

Ft. from S. Line

Ft. from E. Line

330' Ft. from W. Line

NW NW SW

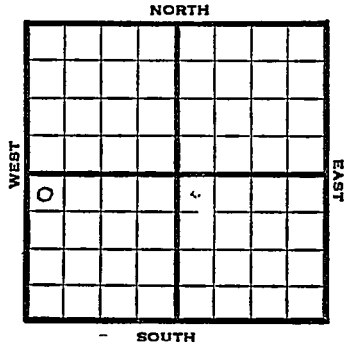

1950

Elev. 2013' REPORT

11/15

Spud 11-14-50
Drlg.

1951
5/2

Spud 11-14-50
Oil well TD 3543'
8" @ 190 Lans. 3225' Cong 3480'
Simp. 3507', Arb. 3533'
DST 3534-43 open 1 hr. rec 480' clean
oil, 5" @ 3534' TD 3543'
FU 2200' oil 12 hr. S/7 BOPH
500 A S/20 BOPH 23 gr.
Comp. deptho. pot. 906 BOPD

COMPLETED

County Ellis State Kansas

Sec. 23 (Blk. Twp.) 11 (Sur. Rge.) 19W Map No.

Operator Brooks Pierce

Well No. 1 Farm Vine

Elev. _____ Location NW NW SW

| | | | | | |
|--|--|--|--|--|--|
| | | | | | |
| | | | | | |
330 Ft. From N Line SW

330 Ft. From W Line Quarter

Ist. Report NOV 15 1950

Completion _____

Remarks Gulf farmout

Brooks Pierce - Contr.

Spudding Date 11-14-50

Drlg. Data Semi Wildcat

drlg.

