


Section 23 Township 11 Range 19 W

Well No. # 2 Vine

Company Continental

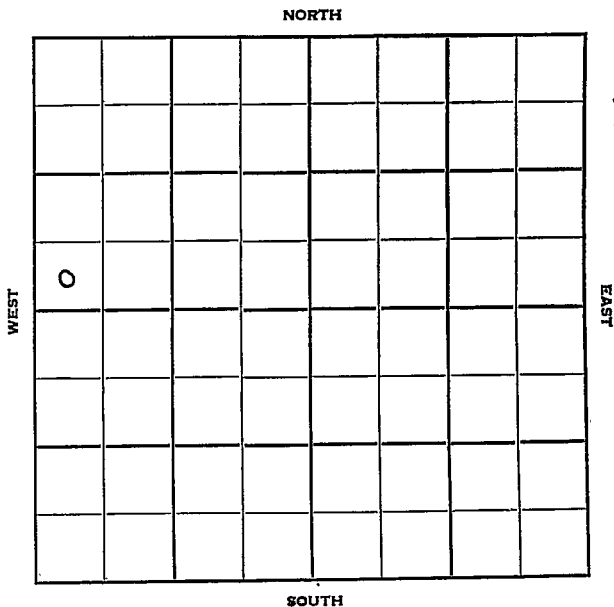

Sec. 23 Twp. 11 R. 19 W

Well No. # 2 Vine Farm

Continental Company

Herndon Drlg. Contractor


Ft. from N. Line

330 Ft. from S. Line

Ft. from E. Line

330 Ft. from W. Line

SW SW NW

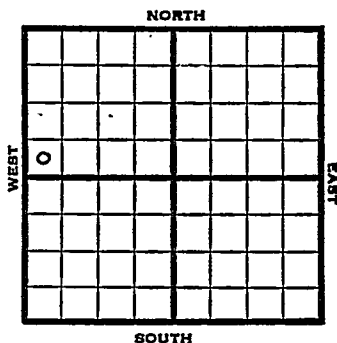

1951 Elev. 1936' REPORT

3/28 Location  
 5/29 Spud 4-15-51  
 Oil Well TD 3488  
 13" @ 132  
 Anhy 1230-75 8" @ 1305  
 Heeb. 3101 Tor. 3125  
 Lans. 3144 Simp. 3421  
 Arb. 3444  
 DST 3452-60 opn 5 min Rec. 430' oil  
 DST 3460-70 opn 15 min. Rec. 30' ocm  
 DST 3470-75 opn 15 min. DST 3470-75  
 opn 15 min. Rec. 60' mud  
 DST 3475-80 opn 15 min. Rec 25' oil  
 60' hocm  
 DST 3480-88 opn 15 min. Rec. 205'  
 mud & sw TD3488 5" @ 3487'  
 12/3482-86 wtr PB 3472  
 94/3444-65 S/38 boph  
 Comp. draw down pot. 1846 bopd  
**COMPLETED**



