

Ellis KANSAS


SEC.	TWP.	R.
23	11	19W

WELL NO. 4 Vine FARM

COMPANY Brooks Pierce

CONTRACTOR Bradenn Drlg.

_____ Ft. from N. Line
990 _____ Ft. from S. Line
 _____ Ft. from E. Line
990 _____ Ft. from W. Line

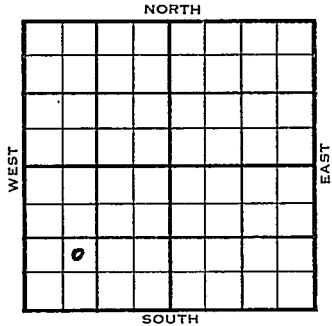

NE SW SE

	ELEVATION	REPORT
1954	2106'	
6/30	Spudding 6-16-54 8" @ 1413 Anhy 1406 Heeb 3288 Lans. 3327 Arb. 3617 TD 3622 5" @ 3620	
7/7	WOCT	
7/21	DD 3627 S/13 BOPH 6 hrs.	
8/25	Spud 6-16-54 Oil Well TD 3627' Anhy 1406' 8" @ 1413' Heeb 3288', Lans 3327', Arb. 3617' TD 3622' 5" @ 3620' DD 3627' S/13 bo. 6 hrs. Comp. 145 bopd	
COMPLETED		

