

Section 23 Township 11 Range 19 W

Well No. # 8 Vine (A)

Company Continental

NORTH

	0						

S

WEST

EAST

SOUTH

Sec. 23 Twp. 11 R. 19W

Well No. #8 Vine (A) Farm

Continental Company

Contractor

Soloman


Ft. from N. Line

330 Ft. from S. Line

Ft. from E. Line

330 Ft. from W. Line

SE SW NW

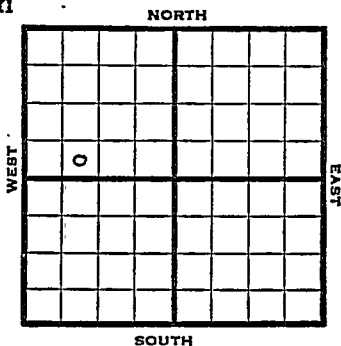

1951

Elev. 1975' REPORT

11/7

Spud 11-3-51  
13" @ 125'  
Drlg. 882'

12/12

Spud 11-3-51  
D&A TD 3532  
13" @ 125 8" @ 1275  
Top. 2918 Heeb. 3146  
Tor. 3164 KC 3187  
Cong. 3430 Simp. 3492  
Arb. 3505-08  
5" @ 3516 CO to 3508 DD 3510  
NS DD 3519 1/4 CBO tr. wtr. 4 hr.  
500 A B/ 1/2 BO 20. BW 8 hr.  
DD 3521 S/ tr. oil 5 BWP  
DD 3529 S/ 30 BW tr. oil 6 hr.  
DD 3532 S/ 10 BW tr. oil 8 hr.  
PB 3502 20/ 3163-73 17/ 3108-16  
16/ 3087-95 19/ 2945-54 2 BW  
2 hr. 1000 A S/ 2 1/2 BWP  
D&A

**ABANDONED**

County Ellis State Kansas

Sec. 23 (Blk. 11 (Sur. 19W Twp.) Rge.) Map No.

Operator Continental

Well No. 8 Farm Vine (A)

Elev. 1975 Location SE SW NW


330 Ft. From S Line NW

990 Ft. From W Line Quarter

Ist. Report NOV 7 1951

Completion \_\_\_\_\_

Remarks \_\_\_\_\_

Spudding Date 11-3-51

Drlg. Data Soloman

13" @ 125 Drlg. 882

J. E. TYRA

