

Ellis KANSAS


SEC. 23	TWP. 11	R. 19W
-------------------	-------------------	------------------

WELL NO. **I DeVine** FARM

COMPANY **Brooks Pierce**

CONTRACTOR **Braden Drlg.**

_____ Ft. from N. Line
330 _____ Ft. from S. Line
330 _____ Ft. from E. Line
 _____ Ft. from W. Line

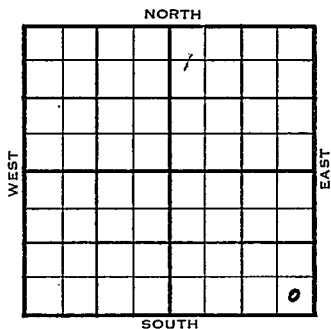

SE SE SE

1954	ELEVATION 2065'	REPORT
------	---------------------------	--------

6/30 M I R
 7/7 8" @ 220'
 Drlg. 3125'

7/21 Heeb 3271' Lans 3310' Simp 3580'
 Arb. 3593' RTD 3600 5" @ 3598

8/25 Spud 6-30-54 - Oil Well
 TD 3600'
 8" @ 220'
 Heeb 3271', Lans 3310', Simp 3580',
 Arb. 3593'
 TD 3600'
 5" @ 3598'
 CO to 3600' 250A
 S/5 boph
 Comp. 26 bopd 32% wtr.

COMPLETED

