


Trego KANSAS

DX 78-1

Section 23 Township 11 Range 21W

Well No. 1 Findley (*Findlay*)

Company Harry Gore

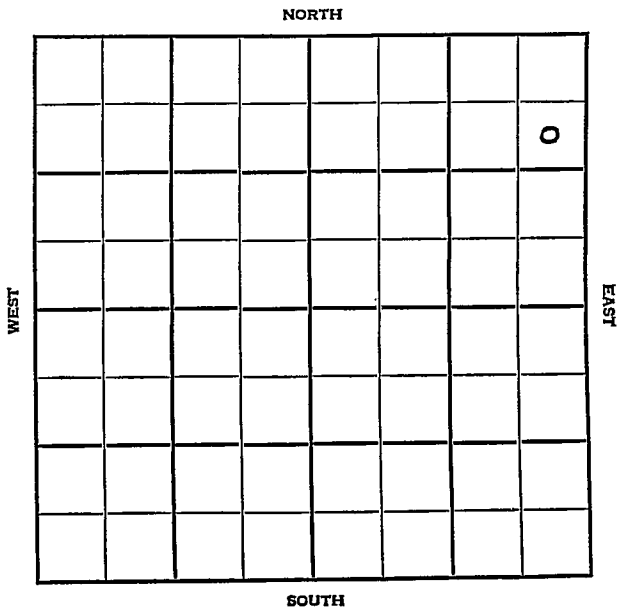

Trego KANSAS

SEC.	TWP.	R.
23	11	21W

WELL NO.

1 Findley

FARM

COMPANY

Harry Gore

CONTRACTOR

Veeder


Walz Pool

990 Ft. from N. Line

Ft. from S. Line

330 Ft. from E. Line

Ft. from W. Line

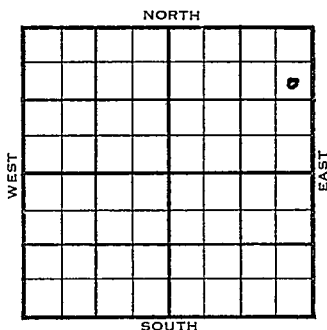


SE NE NE

	ELEVATION	REPORT
1954	2208'	

6/23	Location
6/30	MI
7/7	Drlg. 2613'
8/18	Spud 6-25-54
	Oil Well
	TD 3788'
	8" @ 194'
	Top 3240', Heeb 3450', Tor 3472', Lans 3490', B KC 3715', Arb. 3783'
	TD 3788'
	5" @ 3785',
	CO to 3788', 3000A
	2 1/2 boph
	C omp. 83 bopd

COMPLETED

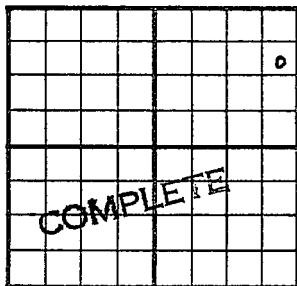County Trego State KansasSec. 23 (Blk.) 11 (Sur.) 21W Map No.Operator Harry GoreWell No. 1 Farm FindlayElev. 2208 Location SE NE NE990 Ft. From N Line NE330 Ft. From E Line Quarter

1st. Report

Completion AUG 18 1954Remarks Walz PoolVeeder - Contr.Spudding Date 6-25-54Drlg. Data Oil well TD 37888" @ 194 Top. 3240 Heeb. 3450Tor. 3472 Lans. 3490 B KC 3715.Arb. 3783 TD 3788 5" @ 3785CO to 3788 3000 A 2 $\frac{1}{2}$ bophComp. 83 bopd

FABEN GILSTRAP