

# KANSAS


Ellis

Form 51-5M-7-39-Palace

Section 23 Township 11 Range 17-W

Well No. #14 Rumsey

Company Cities Service Oil

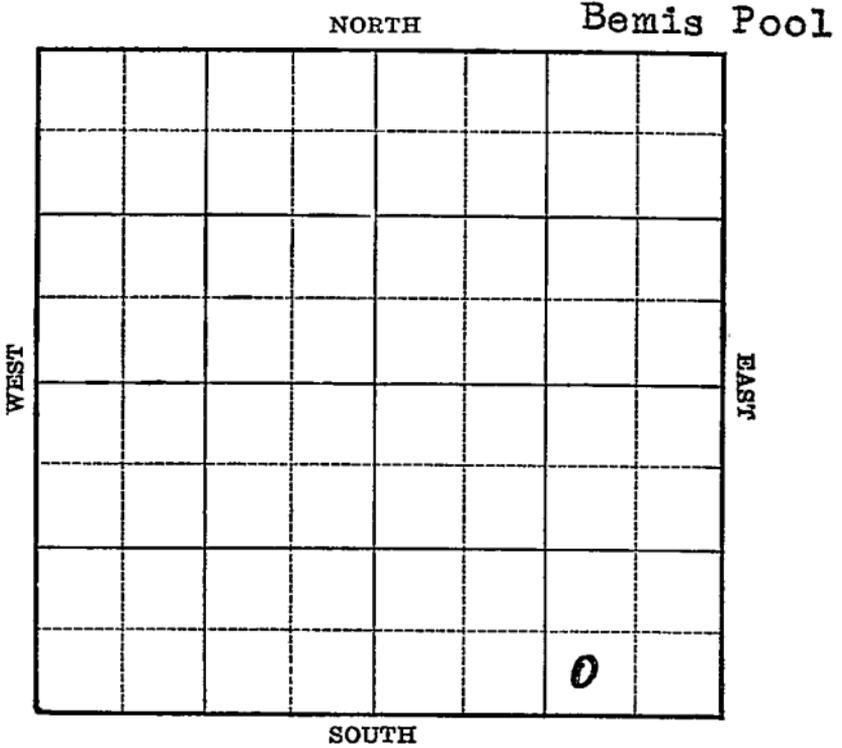

Sec. 23 Twp. 11 R. 17-W

Well No. #14 Rumsey Farm

Cities Service Oil Company


(Bemis)

\_\_\_\_\_ Ft. from N. Line

330 Ft. from S. Line

990 Ft. from E. Line

\_\_\_\_\_ Ft. from W. Line

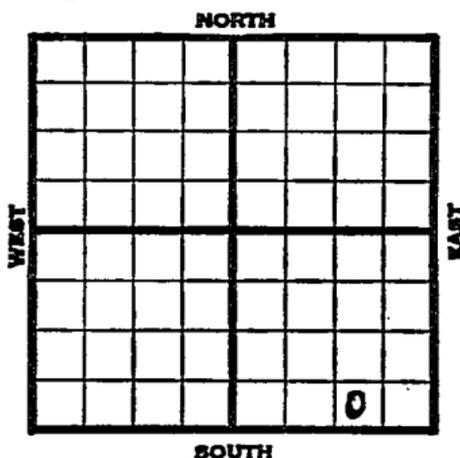

Elev. 2040

1940	REPORT
3/13	Location
3/21	Derrick.
3/28	8" - 1067' WOC.
4/4	Drilg. 3080'
4/12	Arb. 3504-05' T.D. 5" - 3505' No shows reported.
4/18	T.D. 3510' 3000' oil. 500 acid.
4/24	Arb. 3504' 5" - 3505' T.D. 3510' 500 acid.
	Depthograph potential 61821 bbls Maximum 3000 bbls.
	<b>COMPLETED</b>

Map No. 77 Sec. 23 Twp. 11 R. 17W

Well No. 14 Rumsey

Cities Service Oil Company

Contractor

**FIRST REPORT**

**SW SE SE**

         Ft. from N. Line

330 Ft. from S. Line

990 Ft. from E. Line

         Ft. from W. Line

**BEMIS POOL**

**SECTION PLAT**

			o

Location SE

Rig up         

Drilling and Remarks:

**RECORD**

Cased          in.,          ft.

Sand         

Gas         

Oil         

Total Depth         

**PRODUCTION**

1st 24 hrs. Nat.         

1st 24 hrs. after shot         

Gas          Cu. Ft.

Dry Hole         

Abandoned         

Date

MAR 13 1940 19

S. J. LEWIS Scout

Map No. 71 Sec. 23 Twp. 11 R. 17W

Well No. 14 Rumsey

Cities Service Oil Company

Contractor

**COMPLETED**

SW SE SE

\_\_\_\_\_ Ft. from N. Line

330 Ft. from S. Line

990 Ft. from E. Line

\_\_\_\_\_ Ft. from W. Line

**BEMIS POOL**

**SECTION PLAT**


Location \_\_\_\_\_

Rig up \_\_\_\_\_

Drilling and Remarks:

*Core & 3504*  
*5" @ 3505*  
*500 and*  
*Depthograph &*  
*67821*  
  
*Maximum 3000*

**RECORD**

Cased \_\_\_\_\_ in., \_\_\_\_\_ ft.

Sand \_\_\_\_\_

Gas \_\_\_\_\_

Oil \_\_\_\_\_

Total Depth 3510

**PRODUCTION**

1st 24 hrs. Nat. \_\_\_\_\_

1st 24 hrs. after shot \_\_\_\_\_

Gas \_\_\_\_\_ Cu. Ft.

Dry Hole \_\_\_\_\_

Abandoned \_\_\_\_\_

Date

APR 24 1940

S. J. LEWIS Scout