

# KANSAS


Ellis

Form 51-5M-11-38-Palace

Section 23 Township 11 Range 17-W

Well No. #12 Rumsey

Company Cities Service Oil

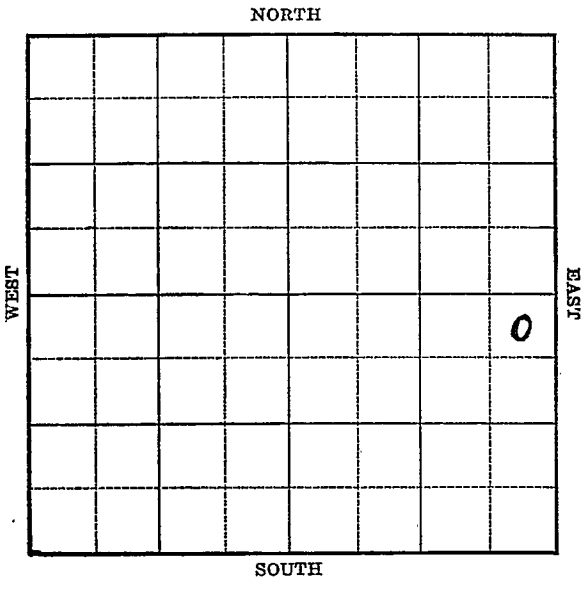

Sec. 23 Twp. 11 R. 17-W

Well No. #12 Rumsey Farm

Cities-Service Oil Company


(Bemis)

330 Ft. from N. Line

\_\_\_\_\_ Ft. from S. Line

330 Ft. from E. Line

\_\_\_\_\_ Ft. from W. Line

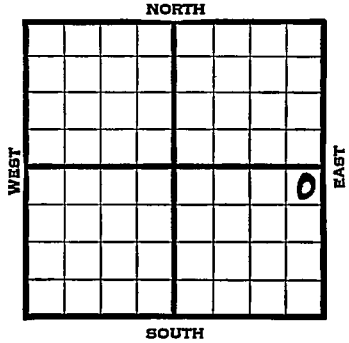

Elev. 1981

1939	REPORT
7/19	Location
7/27	Rotary.
8/3	Drlg. 965'
8/10	8" - 1004' Drlg. 2485'
8/17	3304' lost circulation.
8/24	Arb. 3454' 5" - 3454'
	T.D. 3458' 2950' oil 3½ hours.
	Shut down.
8/31	" "
9/6	Arb. 3454'
	5" - 3455'
	T.D. 3458'
	500 acid.
	Echometer Pot. 29,440 bbls.
	Maximum 2500 bbls.
	COMPLETED

Map No. 77 Sec. 23 Twp. 11 R. 17W

Well No. 12 Rumsey

Cities Service Oil Company

Contractor

FIRST REPORT

SECTION PLAT

NE SE

330 Ft. from N. Line

         Ft. from S. Line

330 Ft. from E. Line

         Ft. from W. Line

			0

BEMIS POOL

Location X

Rig up         

Drilling and Remarks:         

RECORD

Cased          in.,          ft.

Sand         

Gas         

Oil         

Total Depth         

PRODUCTION

1st 24 hrs. Nat.         

1st 24 hrs. after shot         

Gas          Cu. Ft.

Dry Hole         

Abandoned         

Date

JUL 19 1939 19        

S. J. LEWIS Scout

Map No. 71 Sec. 23 Twp. 11 R. 17W

Well No. 12 Rumsey

Cities Service Oil Company

Contractor

· COMPLETED  
NE SE

SECTION PLAT

330 Ft. from N. Line

\_\_\_\_\_ Ft. from S. Line

330 Ft. from E. Line

\_\_\_\_\_ Ft. from W. Line

			0

BEMIS POOL

Location \_\_\_\_\_

RECORD

Rig up \_\_\_\_\_

Cased \_\_\_\_\_ in., \_\_\_\_\_ ft.

Drilling and Remarks: *✓*

Sand \_\_\_\_\_

Gas \_\_\_\_\_

Oil \_\_\_\_\_

Total Depth 3458

*Core 3454*  
*5" @ 3455*  
*500 Acid*  
*Echometer Log*  
*29440'*

PRODUCTION

1st 24 hrs. Nat. \_\_\_\_\_

1st 24 hrs. after shot \_\_\_\_\_

Gas \_\_\_\_\_ Cu. Ft.

Dry Hole \_\_\_\_\_

Abandoned \_\_\_\_\_

*Maximum 2500*

Date

SEP 6 1939 19

S. J. LEWIS Scout