


Section 23 Township 11 Range 17-W

Well No. 10 Rumsey

Company Cities Service Oil

NORTH

Bemis Pool

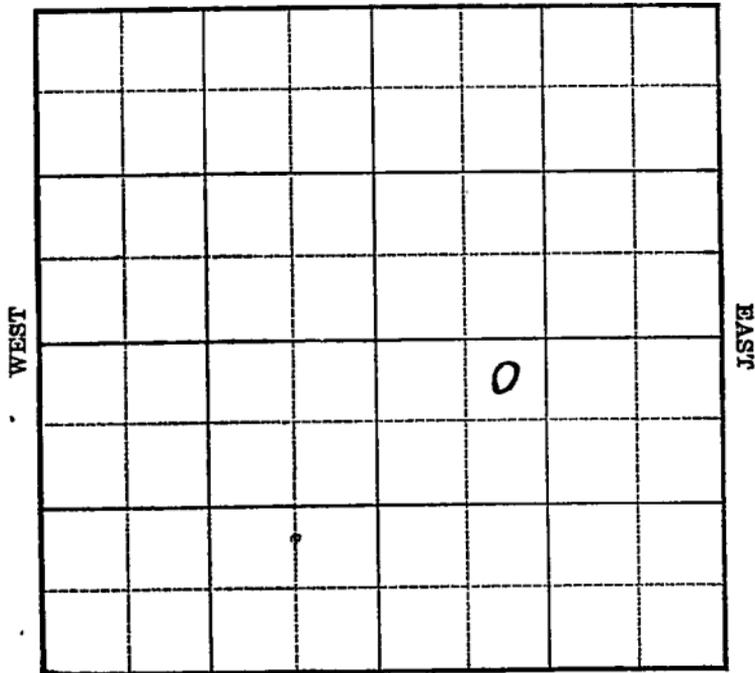

SOUTH

Ellis

KANSAS

Map No. _____ Sec. 23 Twp. 11 R. 17W

Well No. 10 Rumsey

Cities Service Oil Company

Contractor

FIRST REPORT

SECTION PLAT

NE NW SE

330 Ft. from N. Line

_____ Ft. from S. Line

_____ Ft. from E. Line

990 Ft. from W. Line

		o	

BEMIS POOL

Location X

Rig up _____

Drilling and Remarks: _____

RECORD

Cased _____ in., _____ ft.

Sand _____

Gas _____

Oil _____

Total Depth _____

PRODUCTION

1st 24 hrs. Nat. _____

1st 24 hrs. after shot _____

Gas _____ Cu. Ft.

Dry Hole _____

Abandoned _____

Date

MAY 31 1939

19

S. J. LEWIS

Scout

Map No. _____ Sec. 23 Twp. 11 R. 17W

Well No. 10 Rumsey

Cities Service Oil

Company

Contractor

COMPLETED

SECTION PLAT

NE NW SE

330 Ft. from N. Line

_____ Ft. from S. Line

_____ Ft. from E. Line

990 Ft. from W. Line

		o	

BEMIS POOL

Location _____

RECORD

Rig up _____

Cased _____ in., _____ ft.

Drilling and Remarks:

Sand _____

Core 3413

Gas _____

5" @ 3414

Oil _____

500 accl

Total Depth 3418

Eckometel P & Y

PRODUCTION

1st 24 hrs. Nat. _____

20360

1st 24 hrs. after shot _____

Maximum 3500

Gas _____ Cu. Ft.

Dry Hole _____

Abandoned _____

Date

JUL 5 1939 19

C. J. LEWIS Scout