


Section 23 Township 11 Range 17-W

Well No. 7 Rumsey

Company Cities Service Oil

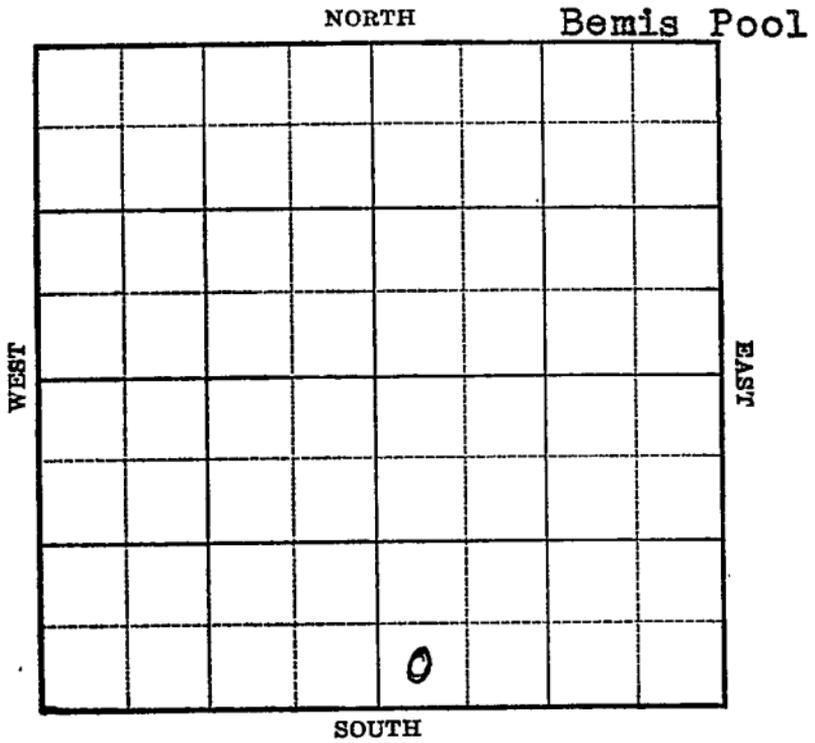

Sec. 23 Twp. 11 R. 17-W

Well No. #7 Rumsey Farm \_\_\_\_\_

Cities Service Oil Company \_\_\_\_\_


(Bemis)

\_\_\_\_\_ Ft. from N. Line

330 Ft. from S. Line

\_\_\_\_\_ Ft. from E. Line

330 Ft. from W. Line

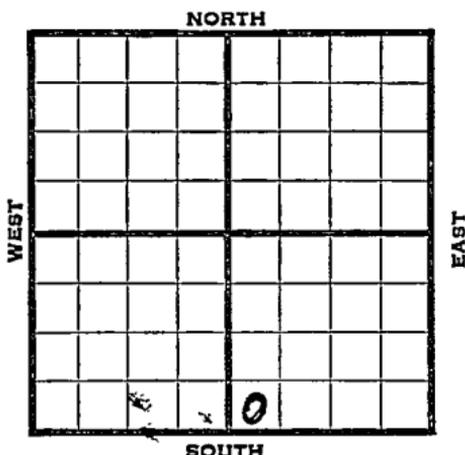

Elev. 1976'

1939	REPORT
3/22	B.R.R.
3/31	8" - 1000' Drlg. 1570'
4/7	Drlg. 2590'
4/14	Arb. 3427-28' T.D. Rng. 5".
4/21	5" - 3428' RUST.
4/26	5" - 3435'
	Arb. 3434'
	T. D. 3439'
	Echometer Gauge 19,053 bbls.
	Maximum potential allowed 3500 bbls.
	<b>COMPLETED</b>



Map No. 7 Sec. 23 Twp. 11 R. 17WWell No. 7 RumseyCities Service Oil Company

Contractor

**COMPLETED**

SW SE

## SECTION PLAT

		0	

\_\_\_\_\_ Ft. from N. Line

330 Ft. from S. Line

\_\_\_\_\_ Ft. from E. Line

330 Ft. from W. Line

BEMIS POOL

Location \_\_\_\_\_

Rig up \_\_\_\_\_

Drilling and Remarks:

Echometer gauge  
19,053 bbls

Maximum Pot-Allowed 3500

## RECORD

Cased 5 in., 3435 ft.Sand Arb 3434

Gas \_\_\_\_\_

Oil \_\_\_\_\_

Total Depth 3439

## PRODUCTION

1st 24 hrs. Nat. \_\_\_\_\_

2nd 24 hrs. after shot \_\_\_\_\_

Gas \_\_\_\_\_ Cu. Ft.

Dry Hole \_\_\_\_\_

Abandoned \_\_\_\_\_

Date

APR 26 1939 19

H. D. Hatfield Scout