

# KANSAS

Form 51-5M-7-39-Palace


Ellis

Section 23 Township 11 Range 17-W

Well No. #27 Rumsey

Company Shell

NORTH Bemis Pool

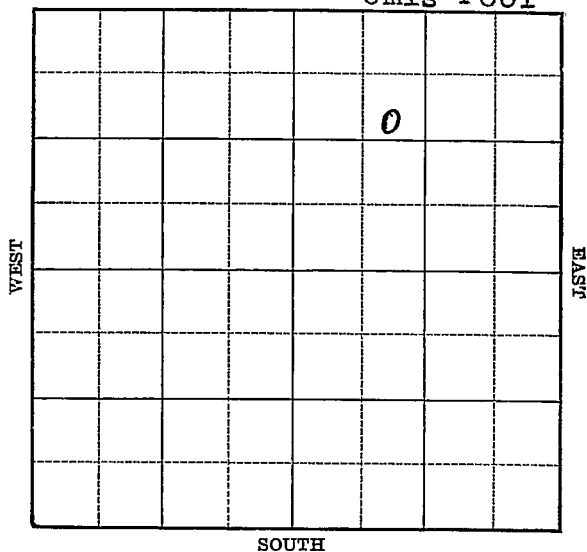



Ellis

KANSAS

Map No. 71 Sec. 23 Twp. 11 R. 17WWell No. 27 RumseyShell

Company

Contractor

## FIRST REPORT

## SECTION PLAT

|  |  |   |  |
|--|--|---|--|
|  |  |   |  |
|  |  | o |  |
|  |  |   |  |
|  |  |   |  |
|  |  |   |  |

SE NW NE

1005 Ft. from N. Line

Ft. from S. Line

Ft. from E. Line

986 Ft. from W. Line

BEMIS POOL

Location X

Rig up

Drilling and Remarks:

## RECORD

Cased \_\_\_\_\_ in., \_\_\_\_\_ ft.

Sand \_\_\_\_\_

Gas \_\_\_\_\_

Oil \_\_\_\_\_

Total Depth \_\_\_\_\_

## PRODUCTION

1st 24 hrs. Nat. \_\_\_\_\_

1st 24 hrs. after shot \_\_\_\_\_

Gas \_\_\_\_\_ Cu. Ft.

Dry Hole \_\_\_\_\_

Abandoned \_\_\_\_\_

Date

OCT 11 1939

19

S. J. LEWIS

Scout

Map No. 71 Sec. 23 Twp. 11 R. 17WWell No. 27 RumseyShell

Company

Contractor

COMPLETED

SE NW NE


1005 Ft. from N. Line

\_\_\_\_\_ Ft. from S. Line

\_\_\_\_\_ Ft. from E. Line

986 Ft. from W. Line

## SECTION PLAT

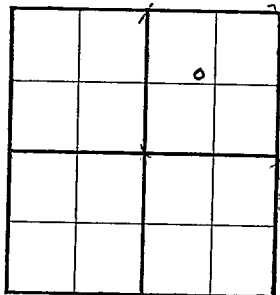

BEMIS POOL

Location \_\_\_\_\_

## RECORD

Cased \_\_\_\_\_ in., \_\_\_\_\_ ft.

Sand \_\_\_\_\_

Gas \_\_\_\_\_

Oil \_\_\_\_\_

Total Depth 3432

## PRODUCTION

1st 24 hrs. Nat. \_\_\_\_\_

1st 24 hrs. after shot \_\_\_\_\_

Gas \_\_\_\_\_ Cu. Ft.

Dry Hole \_\_\_\_\_

Abandoned \_\_\_\_\_

Rig up \_\_\_\_\_

Drilling and Remarks:

*On 83419.**4" @ 3420**Depthograph 18990**Maximum 3500*

Date

NOV 15 1939

19

S. J. LEWIS

Scout