

KANSAS


Form 51—5M—11-38—Palace

Ellis

Section 23 Township 11 Range 17-W

Well No. #22 Rumsey

Company Shell

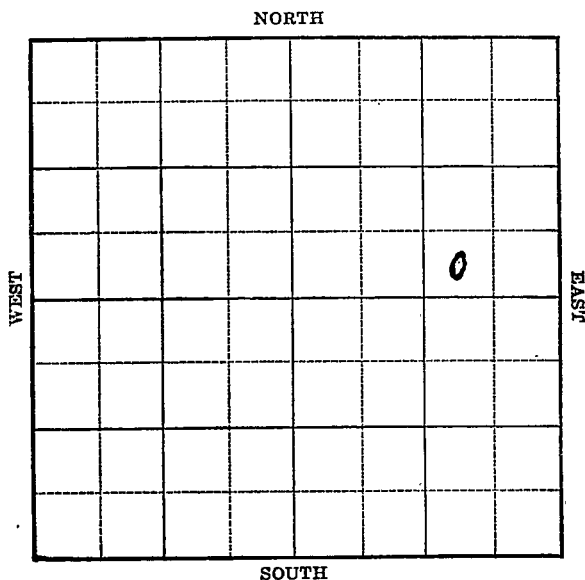

KANSAS


Ellis

Sec. 23 Twp. 11 R. 17-WWell No. #22 Rumsey FarmShell Company

(Bemis)

 Ft. from N. Line330 Ft. from S. Line987 Ft. from E. Line Ft. from W. Line

Elev. 1953

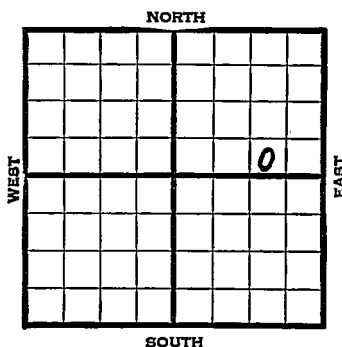

1939	REPORT
7/26	Location
8/3	Drlg. 75'
8/10	13" - 126' 8" - 1154'
	Drlg. 2185'
8/17	Topeka 2859' Drlg. 3207'
8/24	Lans. 3169' Simp. 3403'
	Arb. 3429' 4" - 3440' T.D.
	Shut down.
8/31	4" - 3430' T.D. 3439'
	2920' oil. Shut down.
9/7	Swab 188 oil 3 hours.
9/13	Arb. 3429'
	4" - 3430'
	T.D. 3439'
	Echometer potential 14,774 bbls.
	Maximum 2500 bbls.
	COMPLETED

Ellis

KANSAS

Map No. 71 Sec. 23 Twp. 11 R. 17WWell No. 22 RumseyShell

Company

Contractor

FIRST REPORT

SW SE NE

 Ft. from N. Line330 Ft. from S. Line987 Ft. from E. Line Ft. from W. Line

BEMIS POOL

SECTION PLAT

			0

Location XRig up Drilling and Remarks:

RECORD

Cased in., ft.Sand Gas Oil Total Depth

PRODUCTION

1st 24 hrs. Nat. 1st 24 hrs. after shot Gas Cu. Ft.Dry Hole Abandoned

Date

JUL 26 1939

19

S. I. F. W. Co.

Scout

Map No. _____ Sec. 23 Twp. 11 R. 17WWell No. 22 RumseyShell

Company _____

Contractor _____

COMPLETED

SW SE NE

_____ Ft. from N. Line

330 Ft. from S. Line987 Ft. from E. Line

_____ Ft. from W. Line

BEMIS POOL

SECTION PLAT

Location _____

Rig up _____

Drilling and Remarks:

*Oil 8.3429**4" C 3430**Echoes Tel. P. 8.**14,774 ft.**Maximum 2500*

RECORD

Cased _____ in., _____ ft.

Sand _____

Gas _____

Oil _____

Total Depth. 3439

PRODUCTION

1st 24 hrs. Nat. _____

1st 24 hrs. after shot _____

Gas _____ Cu. Ft.

Dry Hole _____

Abandoned _____

Date

SEP 13 1939

19

S. J. LEWIS

Scout