

Ellis


KANSAS

Form 51—5M—11-38—Palace

Section 23 Township 11 Range 17-W

Well No. 6 Rumsey

Company Cities Service Oil

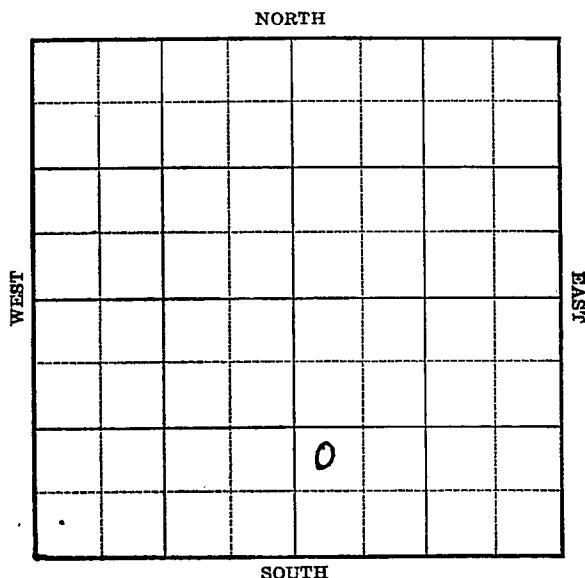

KANSAS

Ellis

Sec. 23 Twp. 11 R. 17-W

Well No. #6 Rumsey Farm

Cities Service Oil _____ Company


Ft. from N. Line

990 Ft. from S. Line

Ft. from E. Line

330 Ft. from W. Line

Elev. 1950

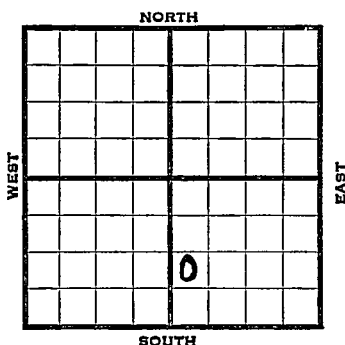

REPORT

1939

11/30

R U R

12/9

10" - 1001'. DrIg. 1846'.

12 / 15

DrIg. 2980!.

12/23

Arb. 3410'. T. D. 3411'.

7" - 3411'. RUST.

12 / 28

7" - 3411'.

Arb. 3410'.

T. D. 34161.

Pump 198 bbls. 8 hours.

Potential 593 bbls. Nat'l.

COMPLETED

Map No. 71 Sec. 23 Twp. 11 R. 17WWell No. 6 RumseyCities Service Oil Company

Contractor

FIRST REPORT

NW SW SE

 Ft. from N. Line990 Ft. from S. Line Ft. from E. Line330 Ft. from W. Line

SECTION PLAT

		0	

Location Rig up

Drilling and Remarks:

RUR

RECORD

Cased in., ft.Sand Gas Oil Total Depth

PRODUCTION

1st 24 hrs. Nat. 1st 24 hrs. after shot Gas Cu. Ft.Dry Hole Abandoned

Date

NOV 30 1938

19

H. D. Hatfield Scout

Ellis

KANSAS

Map No. 71 Sec. 23 Twp. 11 R. 17WWell No. 6 Rumsey

Cities Service Oil

Company

Contractor

COMPLETED

NW SW SE

 Ft. from N. Line990 Ft. from S. Line Ft. from E. Line330 Ft. from W. Line

SECTION PLAT

		0	

BEMIS POOL

Location Rig up

Drilling and Remarks:

*P-198/8**POT 593**NAT*

RECORD

Cased 7 in., 3411 ft.Sand Arb 3410Gas Oil Total Depth 3416

PRODUCTION

1st 24 hrs. Nat. 1st 24 hrs. after shot Gas Cu. Ft.Dry Hole Abandoned

Date

DEC 28 1938

19

H. D. Hatfield

Scout