

KANSAS

Ellis

Sec. 23 Twp. 11 R. 17-W

Well No. #21 Rumsey Farm _____

Shell Company _____


(Bemis)

_____ Ft. from N. Line

330 Ft. from S. Line

_____ Ft. from E. Line

987 Ft. from W. Line

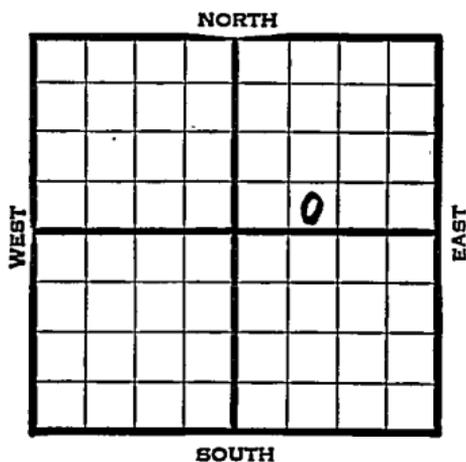

Elev. 1932

1939	REPORT
7/12	Rotary.
7/20	13" - 135' Drlg. 1060'
7/27	8" - 1121' Drlg. 2805'
8/3	Topeka 2840' Lans. 3148'
	Cong. 3371' Simp. 3383'
	Arb. 3407' 4" - 3408' RUST.
8/10	T.D. 3417' Swab 235 oil 4 hrs.
8/17	SD.
8/23	Arb. 3407'
	4" - 3408'
	T.D. 3417'
	Depthograph potential 14,410 bbls
	Maximum 3500 bbls.
	COMPLETED

Map No. _____ Sec. 23 Twp. 11 R. 17WWell No. 21 RumseyShell

Company _____

Contractor _____

FIRST REPORT

SE SW NE

_____ Ft. from N. Line

330 Ft. from S. Line

_____ Ft. from E. Line

987 Ft. from W. Line

BEMIS POOL

SECTION PLAT

Location _____

Rig up _____

Drilling and Remarks:

Rotary

RECORD

Cased _____ in., _____ ft.

Sand _____

Gas _____

Oil _____

Total Depth _____

PRODUCTION

1st 24 hrs. Nat. _____

1st 24 hrs. after shot _____

Gas _____ Cu. Ft.

Dry Hole _____

Abandoned _____

Date

JUL 12 1935
19

S. J. LEWIS

Scout

Map No. 71 Sec. 23 Twp. 11 R. 17 W

Well No. 21 Runsey

Shell Company

Contractor

SE. 80. NE

COMPLETED

_____ Ft. from N. Line

330 Ft. from S. Line

_____ Ft. from E. Line

987 Ft. from W. Line

SECTION PLAT

		0	

Bemis Pool

Location _____

Rig up _____

Drilling and Remarks:

Cu & 3407
4" @ 3408
Depthograph 28
14470

Maximum 3500

RECORD

Cased _____ in., _____ ft.

Sand _____

Gas _____

Oil _____

Total Depth 3417

PRODUCTION

1st 24 hrs. Nat. _____

1st 24 hrs. after shot _____

Gas _____ Cu. Ft.

Dry Hole _____

Abandoned _____

Date

AUG 23 1939

19

S J. LEWIS

Scout