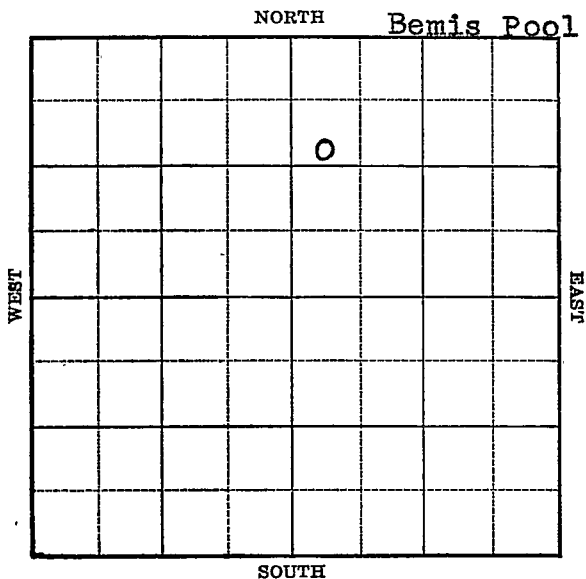


Section 23 Township 11 Range 17-WWell No. 18 RumseyCompany Shell

Ellis

KANSAS

Map No. 71 Sec. 23 Twp. 11 R. 17WWell No. 18 RumseyShell

Company

Contractor

COMPLETE

SW NW NE

SECTION PLAT1003 Ft. from N. Line Ft. from S. Line Ft. from E. Line330 Ft. from W. Line

		o	

BEMIS POOLLocation Rig up

Drilling and Remarks:

*Cu. 8.3375**4 1/2" @ 3376**Depth graph
P & 8500***RECORD**Cased in., ft.Sand Gas Oil Total Depth 3385**PRODUCTION**1st 24 hrs. Nat. 1st 24 hrs. after shot Gas Cu. Ft.Dry Hole Abandoned

Date

JUN 28 1939 19

S. J. LEWIS

Scout