

Ellis


KANSAS

FORM 51 5M 2-38 TPCO.

Section 23 Township 11 Range 17-W

Well No. 13 Rumsey

Company Shell

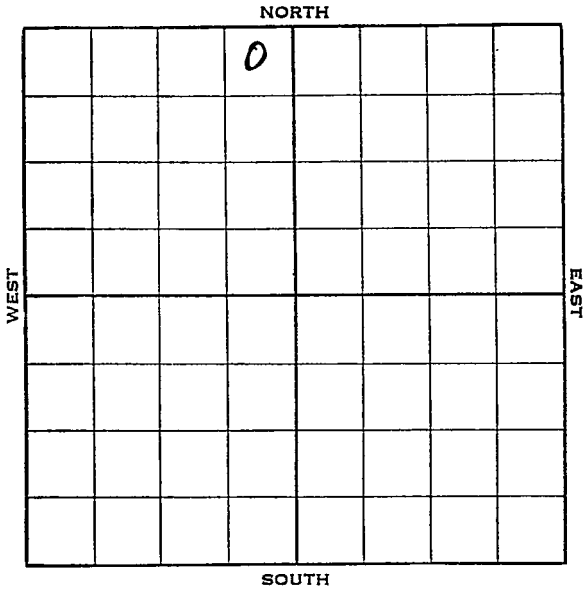

Ellis

Sec. 23 Twp. 11 R. 17-W


Well No. #13 Rumsey Farm
Shell Company

330 Ft. from N. Line

Ft. from S. Line

330 Ft. from E. Line

Ft. from W. Line

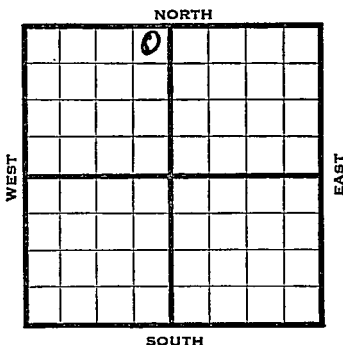

Elev. 1880'.

[illegible]

Map No. 71 Sec. 23 Twp. 11 R. 17WWell No. 13 RumseyShell

Company

Contractor

FIRST REPORT

NE NW

330 Ft. from N. Line Ft. from S. Line330 Ft. from E. Line Ft. from W. Line

SECTION PLAT

		0	

Location Rig up

Drilling and Remarks:

RR

RECORD

Cased in., ft.Sand Gas Oil Total Depth

PRODUCTION

1st 24 hrs. Nat. 1st 24 hrs. after shot Gas Cu. Ft.Dry Hole Abandoned

Date

SEP 1 st 1938

19

H. D. Hatfield

Scout

Map No. _____ Sec. 23 Twp. 11 R. 17WWell No. 13 Rumsey

Shell _____ Company _____

Contractor _____

COMPLETED330 NE NW
Ft. from N. Line

_____ Ft. from S. Line

330 Ft. from E. Line

_____ Ft. from W. Line

SECTION PLAT

	0		

Location _____

Rig up _____

Drilling and Remarks:

POT 3391
NOT

RECORDCased 7 in. 3370 ft.Sand Arb 3369

Gas _____

Oil _____

Total Depth 3380**PRODUCTION**

1st 24 hrs. Nat. _____

1st 24 hrs. after shot _____

Gas _____ Cu. Ft.

Dry Hole _____

Abandoned _____

Date

OCT 12 1938 19 H. D. Hatfield Scout