



Sec. 23 Twp. 11 R. 17-W

Well No. #17 Rumsley Farm

Shell Company


(Bemis)

330 Ft. from N. Line

\_\_\_\_\_ Ft. from S. Line

\_\_\_\_\_ Ft. from E. Line

330 Ft. from W. Line

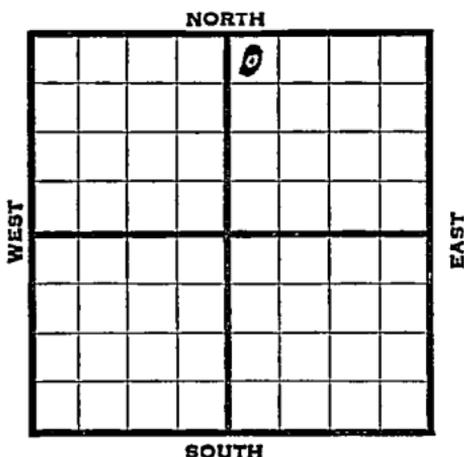

1939	REPORT
5/3	Rotary
5/12	13" - 95' 8" - 1097'
	T.D. 1102' WOC.
5/19	Drig. 2825'
5/26	Topeka 2807' Cong. 3340'
	Arb. 3377' T.D. 3379'
	4" - 3378' WOC.
6/1	" " "
6/7	Arb. 3377 4" 3378
	T.D. 3387
	Pot. 28 bbls.
	<b>COMPLETED</b>

Map No. 71 Sec. 23 Twp. 11 R. 17WWell No. 17 RumseyShell Company

Contractor

## FIRST REPORT

## SECTION PLAT

		0	

330 NW NE  
Ft. from N. Line

\_\_\_\_\_ Ft. from S. Line

\_\_\_\_\_ Ft. from E. Line

330 Ft. from W. Line

## BEMIS POOL

Location \_\_\_\_\_

Rig up \_\_\_\_\_

Drilling and Remarks:

ROTARY

## RECORD

Cased \_\_\_\_\_ in., \_\_\_\_\_ ft.

Sand \_\_\_\_\_

Gas \_\_\_\_\_

Oil \_\_\_\_\_

Total Depth \_\_\_\_\_

## PRODUCTION

1st 24 hrs. Nat. \_\_\_\_\_

1st 24 hrs. after shot \_\_\_\_\_

Gas \_\_\_\_\_ Cu. Ft.

Dry Hole \_\_\_\_\_

Abandoned \_\_\_\_\_

Date

MAY 3 1939

19

S. I. LEWIS Scout

Map No. 71 Sec. 23 Twp. 11 R. 17W

Well No. 17 Rumsey

Shell Company

Contractor

COMPLETED

SECTION PLAT

NW NE  
330 Ft. from N. Line  
Ft. from S. Line  
Ft. from E. Line  
330 Ft. from W. Line

		o	
		X	

BEMIS POOL

Location \_\_\_\_\_

Rig up \_\_\_\_\_

Drilling and Remarks:

*Core 3277  
4" @ 3278  
  
P & 28 8 1/2*

RECORD

Cased \_\_\_\_\_ in., \_\_\_\_\_ ft.  
Sand \_\_\_\_\_  
Gas \_\_\_\_\_  
Oil \_\_\_\_\_  
Total Depth 3387

PRODUCTION

1st 24 hrs. Nat. \_\_\_\_\_  
1st 24 hrs. after shot \_\_\_\_\_  
Gas \_\_\_\_\_ Cu. Ft.  
Dry Hole \_\_\_\_\_  
Abandoned \_\_\_\_\_

Date

JUN 7 1939 19

S. J. LEWIS Scout