

Ellis


O. W. D. D.

KANSAS

Section 23 Township 11 Range 17-W

Well No. #12 Rumsey

Company Shell

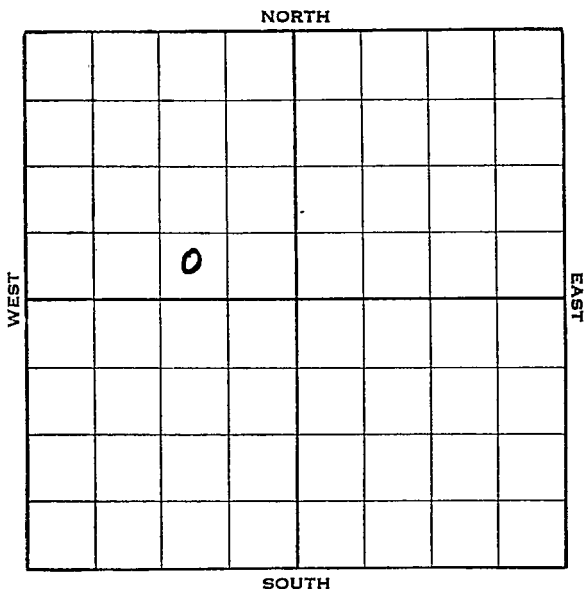

KANSAS

Ellis


O. W. D. D.

Sec. 23 Twp. 11 R. 17-WWell No. #12 Rumsey Farm
Shell Company

Ft. from N. Line

330 Ft. from S. Line990 Ft. from E. Line

Ft. from W. Line

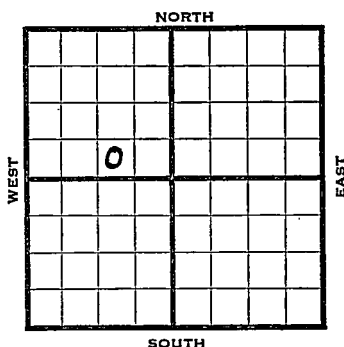

Elev. 1895'.

1938	REPORT
9/7	Location
9/16	16" - 129'. 10" - 1100'. WOC.
9/23	Dlg. 2672'.
9/30	Topeka 2804'. Lans. 3115'.
	Cong. 3330'. Arb. 3372-72'.
	7" - 3371'. RUST.
10/5	7" - 3371'.
	Arb. 3370'.
	T. D. 3390'.
	Potential 3321 bbls.
	COMPLETED
1956	
	O. W. D. D.
8-15	7" @ 3371; DD 3422
	Run 75' of 5" OD liner to 3421/75
	DD 3426; S/ 20 bfph,
	P/4 bo 182 bwpd
	DD 3431 ; 500 A
	FIRST REPORT
	COMPLETED
	P/ 13 bo 645 bwpd, Comp.
	Tp. 2804'; L. 3115'; C. 3330'; S. 3352';
	A. 3370';
	Log tops; Tp. 2803'; Tr. 3062'; L. 3084';
	S. 3343'; A. 3370'; TD 3372'

Ellis

KANSAS

Map No. _____ Sec. 23 Twp. 11 R. 17WWell No. 12 RumseyShell

Company

Contractor

FIRST REPORT**SW SE NW****SECTION PLAT**

	o		

_____ Ft. from N. Line

330 Ft. from S. Line990 Ft. from E. Line

_____ Ft. from W. Line

Location X

Rig up _____

Drilling and Remarks:

RECORD

Cased _____ in., _____ ft.

Sand _____

Gas _____

Oil _____

Total Depth _____

PRODUCTION

1st 24 hrs. Nat. _____

1st 24 hrs. after shot _____

Gas _____ Cu. Ft.

Dry Hole _____

Abandoned _____

Date

SEP 7 - 1938 19ORVAL MANNSCHRECK

Scout

Ellis

KANSAS

Map No. 71 Sec. 23 Twp. 11 R. 17WWell No. 12 RumseyShell

Company

Contractor

COMPLETED

SW SE NW

____ Ft. from N. Line

330 Ft. from S. Line990 Ft. from E. Line

____ Ft. from W. Line

SECTION PLAT

	0		

Location _____

Rig up _____

Drilling and Remarks:

POT 3321

RECORD

Cased 7 in., 3371 ft.Sand Arb 3370

Gas _____

Oil _____

Total Depth 3390

PRODUCTION

1st 24 hrs. Nat. _____

1st 24 hrs. after shot _____

Gas _____ Cu. Ft.

Dry Hole _____

Abandoned _____

Date

OCT 5 - 1938 19

H. D. Hatfield Scout

O. W. D. D.

FORM 513 SUNRAY

County Ellis Elev. 1895
 Sec. 23 Twp. 11 Rge. 17W
 Company Shell Oil
 Farm Name Rumsey No. 12

TOPS	DEPTH	LOG	DATUM	Loc. in Sec.
Anh.	2804	2803		SW SE NW
Tr.				OWDD
Dg.		3062		
BL.				
L.	3115	3084		
K.C.				Geol.
B.K.C.				Contr.
Ce.				
C.	3330			
M.				Pool
M.				
K.				
Mz.				
Mo.				
V.				
S.	3352	3343		COMPLETE
S.				
A.	3370	3370		
R.				
Pe.				
G.				
TD.	3372			FIRST REPORT

Date Comm.

AUG 15 '56

7" @ 3371 DD3422 ran 75' of 5" OD
 liner to 3421/75 DD 3426 S/ 20 bph
 P/ 4 bo 182 bwpd DD 3431 500 A
 P/ 13 bo 645 bwpd Comp.

3001 4 2 344

647

[Handwritten signature]