


Section 23 Township 11 Range 17-W

Well No. 8 Rumsey

Company Shell

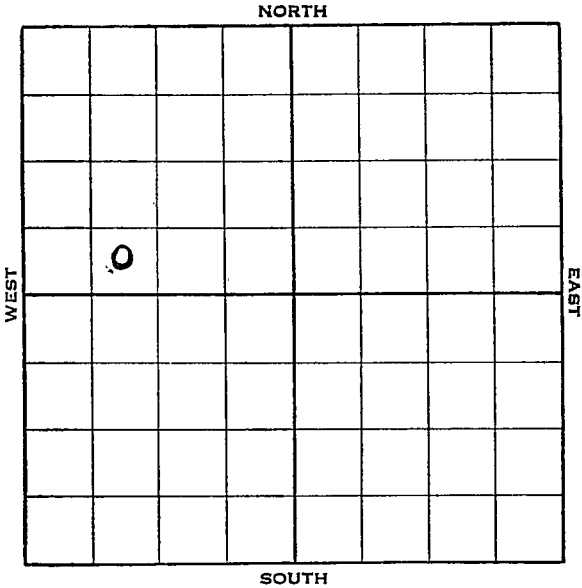

Sec. 23 Twp. 11 R. 17-W

Well No. #8 Rumsey Farm


Shell Company

_____ Ft. from N. Line

330 Ft. from S. Line

_____ Ft. from E. Line

983 Ft. from W. Line

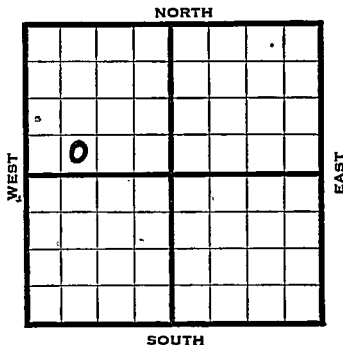

Elev. 1876

| 1938 | REPORT |
|-------|----------------------------|
| 8/10 | 15" - 135'. |
| | Dlg. 880'. |
| 8/19 | 10" - 1095'.. Dlg. 2160'.. |
| 8/26 | Topeka 2793'. Lans. 3105'. |
| | Cong. 3309'. Simp. 3323'.. |
| | Arb. 3347-49' T.D. S. O. |
| | 7" - 3348'. RUST. |
| 9/2 | T. D. 3367'. 2900' oil. |
| | Pump 172 oil in 3 hrs. |
| 9/9 | " " " " |
| 9/16 | TD 3367' SD. |
| 9/23 | " " |
| 9/30 | " " |
| 10/7 | " " |
| 10/14 | " " |
| 10/21 | " " |
| | |
| | OVER |
| | |
| | |

1938

10/26 7" - 3348'.

Arb. 3347'.

T. D. 3367'.

2000 acid.

Potential 3374 bbls.

COMPLETED

Ellis KANSAS

Map No. 71 Sec. 23 Twp. 11 R. 17W

Well No. 8 Rumsey

Shell

Company

Contractor

FIRST REPORT
SE SW NW

SECTION PLAT

_____ Ft. from N. Line

330 Ft. from S. Line

_____ Ft. from E. Line

983 Ft. from W. Line

| | | | |
|---|--|--|--|
| | | | |
| 0 | | | |
| | | | |
| | | | |

Location _____

RECORD

Rig up _____

Cased _____ in., _____ ft.

Drilling and Remarks:

Sand _____

15" - 135

Gas _____

Drlg. 880

Oil _____

Total Depth _____

PRODUCTION

1st 24 hrs. Nat. _____

1st 24 hrs. after shot _____

Gas _____ Cu. Ft.

Dry Hole _____

Abandoned _____

Date

AUG 10 1938 19

H. D. Hatfield Scout

RAY

| | |
|-----------------------|-------|
| Returned | _____ |
| Cards | _____ |
| Tracing | _____ |
| France Map | _____ |
| Scarborough Map | _____ |
| Moody Map | _____ |
| Scarborough Plat Book | _____ |
| Moody Plat Book | _____ |

Map No. _____ Sec. 23 Twp. 11 R. 17W

Well No. 8-Rumsey

Shell Company

Contractor

COMPLETED

SE SW NW

SECTION PLAT

_____ Ft. from N. Line

330 Ft. from S. Line

_____ Ft. from E. Line

983 Ft. from W. Line

| | | | |
|---|--|--|--|
| | | | |
| | | | |
| o | | | |
| | | | |

Location _____

Rig up _____

Drilling and Remarks:

2000 Acid

POT 3374

RECORD

Cased 7 in., 3348 ft.

Sand 4-6 3347

Gas _____

Oil _____

Total Depth 3367

PRODUCTION

1st 24 hrs. Nat. _____

1st 24 hrs. after shot _____

Gas _____ Cu. Ft.

Dry Hole _____

Abandoned _____

Date

SEP 26 1938

H. D. Hatfield Scout

