



Sec. 23 Twp. 11 R. 17-W

Well No. #5 Rumsey Farm \_\_\_\_\_  
Shell Company \_\_\_\_\_


\_\_\_\_\_ Ft. from N. Line

330 Ft. from S. Line

\_\_\_\_\_ Ft. from E. Line

330 Ft. from W. Line

**Elev. 1895**

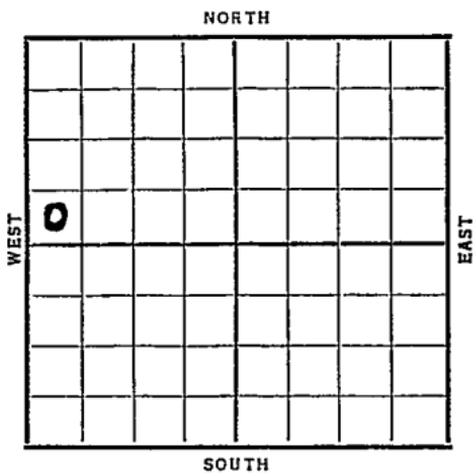

Date	REPORT
1938	
2/23	Location
3/4	Rng. 15" @ 300'.
3/11	16" @ 197'. Anhy 1094'.
	10" @ 1096'. Drlg. 1920'.
3/18	Drlg. 2789'.
3/25	Topeka 2788'. Lans. 3125'.
	Arb. 3373'. T.D. 3376'. S.O.
	7" @ 3374'. RUST.
4/1	T.D. 3388'. 2900' oil.
4/6	7" @ 3374'.
	Arb. 3373'.
	T.D. 3388'.
	Potential 2642 bbls.
	<b>COMPLETED</b>

Map No. 71 Sec. 23 Twp. 11 R. 17WWell No. 5 RumseyShe 11

Company

Contractor

**FIRST REPORT**

SW NW

         Ft. from N. Line330 Ft. from S. Line         Ft. from E. Line330 Ft. from W. Line**SECTION PLAT**

0			

Location   /  Rig up         

Drilling and Remarks:

**RECORD**Cased          in.,          ft.Sand         Gas         Oil         Total Depth         **PRODUCTION**1st 24 hrs. Nat.         1st 24 hrs. after shot         Gas          Cu. Ft.Dry Hole         Abandoned         

Date

FEB 23 1938 19H. D. Hatfield

Scout

Ellis

KANSAS

Map No. 71 Sec. 23 Twp. 11 R. 17W

Well No. 5 Rumsey

Shell

Company

Contractor

**COMPLETED**

SW NW

         Ft. from N. Line

330 Ft. from S. Line

         Ft. from E. Line

330 Ft. from W. Line

**SECTION PLAT**

0			

Location                                 

Rig up                                 

Drilling and Remarks:

*LOT 2642*

**RECORD**

Cased 7 in., 3374 ft.

~~Sand~~ Arb 3373

Gas                                 

Oil                                 

Total Depth 3388

**PRODUCTION**

1st 24 hrs. Nat.                         

1st 24 hrs. after shot                         

Gas                                  Cu. Ft.

Dry Hole                                 

Abandoned                                 

Date

APR 6 - 1938 19

H. D. Hatfield Scout