


Section 23 Township 11 Range 23W

Well Number #1 Carpenter

Company Continental

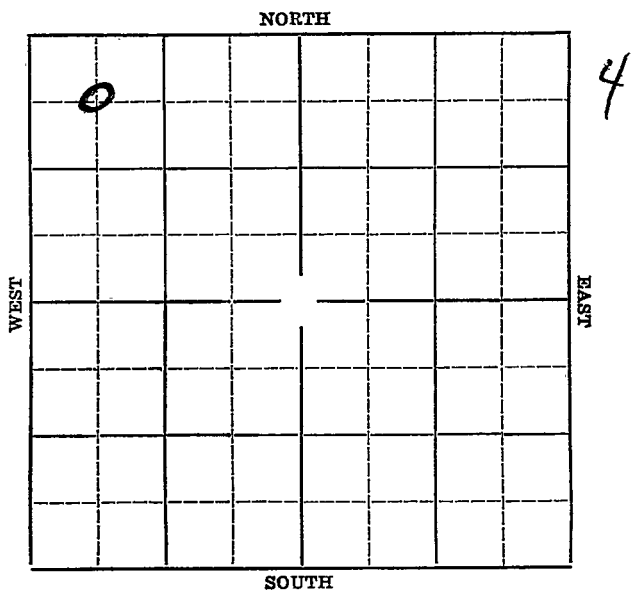

Map No. KANSAS Sec. 23 Twp. 11 R. 23W

Well No. #1 Carpenter Farm

Continental


Company

660' Ft. from N. Line

\_\_\_\_\_ Ft. from S. Line

\_\_\_\_\_ Ft. from E. Line

660' Ft. from W. Line

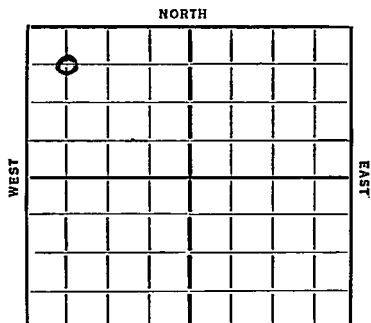

Elev. 2296 SOUTH

1936

REPORT

5/20 Location.

5/28 Spud

6/4 46' of 15". 850' of 13". Drlg. 1100'

6/11 Drlg. 2475'.

6/18 Drlg. 3245'.

6/25 Oswald 3537'. 6" @ 3542'. RUST.

7/2 --7/99--

7/16 Gorham 3593-3608'. T.D. 15 bbls of oil and 35 bbls of water per day.

7/23 3657' clean out.

7/30 20 to 25 bbls of oil show. 3625'.  
Run 5" @ 3693'

8/6 5" @ 3696'. Cleaning out.

8/13 Show oil 3755'. Drlg. 3770'.

8/20 3775' shut down.

8/27 Plug back to 3580'. No test.

9/3 --

9/9/36 -Oswald 3537'. T.D. 3775'.  
P.B. to 3580'.  
2000 gallons acid. **ABANDONED**  
Swab 5 bbls oil 425 water.

Map No. 69 Sec. 23 Twp. 11 R. 23W

Well No. 1 Carpenter

Continental Company

Contractor

**SECTION PLAT**

0			

660 Ft. from N. Line

\_\_\_\_\_ Ft. from S. Line

\_\_\_\_\_ Ft. from E. Line

660 Ft. from W. Line

**FIRST REPORT**

Location ✓

Rig up \_\_\_\_\_

Drilling and Remarks:

**RECORD**

Cased \_\_\_\_\_ in., \_\_\_\_\_ ft.

Sand \_\_\_\_\_

Gas \_\_\_\_\_

Oil \_\_\_\_\_

Total Depth \_\_\_\_\_

**PRODUCTION**

1st 24 hrs. Nat. \_\_\_\_\_

1st 24 hrs. after shot \_\_\_\_\_

Gas \_\_\_\_\_ Cu. Ft.

Dry Hole \_\_\_\_\_

Abandoned \_\_\_\_\_

Date

MAY 20 1936 19

S. J. LEWIS

Scout

KANSAS

Map No. 69 Sec. 23 Twp. 11 R. 23W

Well No. 1 Carpenter

Continental Company

Contractor

SECTION PLAT

0			

660 Ft. from N. Line

\_\_\_\_\_ Ft. from S. Line

\_\_\_\_\_ Ft. from E. Line

660 Ft. from W. Line

ABANDONED

Location \_\_\_\_\_

Rig up \_\_\_\_\_

Drilling and Remarks:

Dwa 663537

P.B 3580

20000 cu ft

swab 5 bbls oil 425 ft

1/2 bbl oil

J.J.A.

RECORD

Cased \_\_\_\_\_ in., \_\_\_\_\_ ft.

Sand \_\_\_\_\_

Gas \_\_\_\_\_

Oil \_\_\_\_\_

Total Depth 3775

PRODUCTION

1st 24 hrs. Nat. \_\_\_\_\_

1st 24 hrs. after shot \_\_\_\_\_

Gas \_\_\_\_\_ Cu. Ft.

Dry Hole \_\_\_\_\_

Abandoned \_\_\_\_\_

Swab 5 bbls oil 425 water

Date

SEP 9 1936 19

S. J. LEWIS Scout