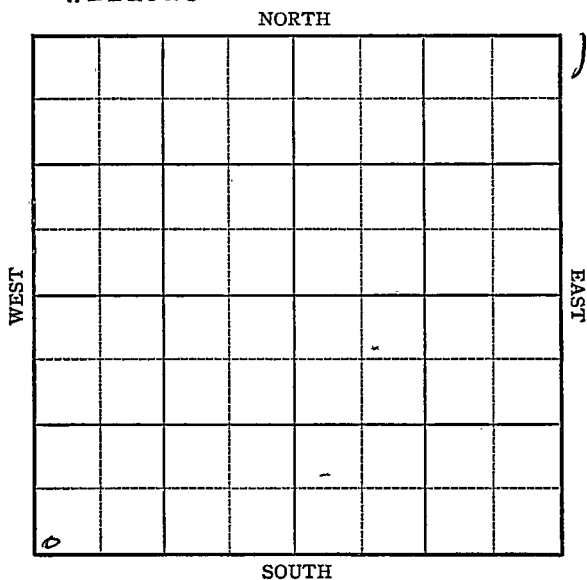


Wallace KANSAS

Section 23 Township 11 Range 39-WWell No. #1-A Wallace InvestmentCompany Sinclair-Prairie
Wildcat

Wallace

KANSAS

Sec. 23 Twp. 11 R. 39-W

Well No. #1-A Wallace Investment Farm

Sinclair-Prairie

Company


(Wildcat)

 Ft. from N. Line

330 Ft. from S. Line

 Ft. from E. Line

100 Ft. from W. Line

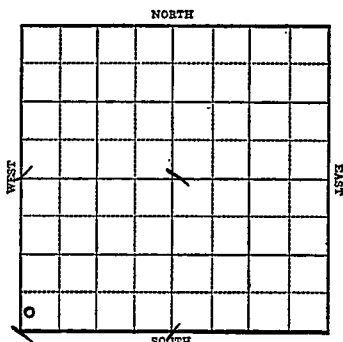

SW/C

1942

R E P O R T

10/14

Derrick

10/21

"

10/29

Derrick ~~invest~~

11/4

Location

ABANDONED

Wallace

KANSAS


Map No. MM Sec. 23 Twp. 11 R. 39WWell No. 1-A Wallace InvestmentSinclair-Prairie Company

FIRST REPORT

Contractor

SW/C

SECTION PLAT

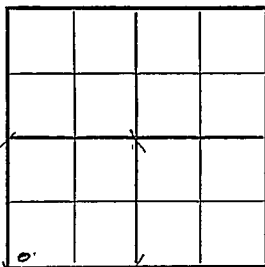

_____ Ft. from N. Line

330 _____ Ft. from S. Line

_____ Ft. from E. Line

100 _____ Ft. from W. Line

WILDCA T

Location _____

Rig up _____

Drilling and Remarks:

Derrick

RECORD

Cased _____ in., _____ ft.

Sand _____

Gas _____

Oil _____

Total Depth _____

PRODUCTION

1st 24 hrs. Nat. _____

1st 24 hrs. after shot _____

Gas _____ Cu. Ft.

Dry Hole _____

Abandoned _____

Date

OCT 14 1942 19

S. J. LEWIS

Scout


KANSAS

Wallace

Map No. MM Sec. 23 Twp. 11 R. 39WWell No. 1-A Wallace InvestmentSinclair-Prairie CompanyABANDONED Contractor

SW/C

SECTION PLAT

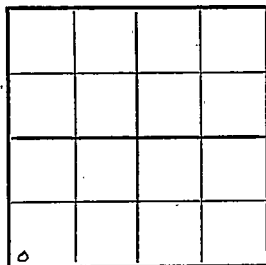 Ft. from N. Line330 Ft. from S. Line Ft. from E. Line100 Ft. from W. Line

WILDCAT

Location ✓Rig up

Drilling and Remarks:

RECORD

Cased in., ft.Sand Gas Oil Total Depth

PRODUCTION

1st 24 hrs. Nat. 1st 24 hrs. after shot Gas Cu. Ft.Dry Hole Abandoned

Date

NOV 4 1942 19 S. J. LEWIS Scout