


Section 23 Township 11 Range 17-W

Well No. 1 Rumsey

Company Cities Service Oil

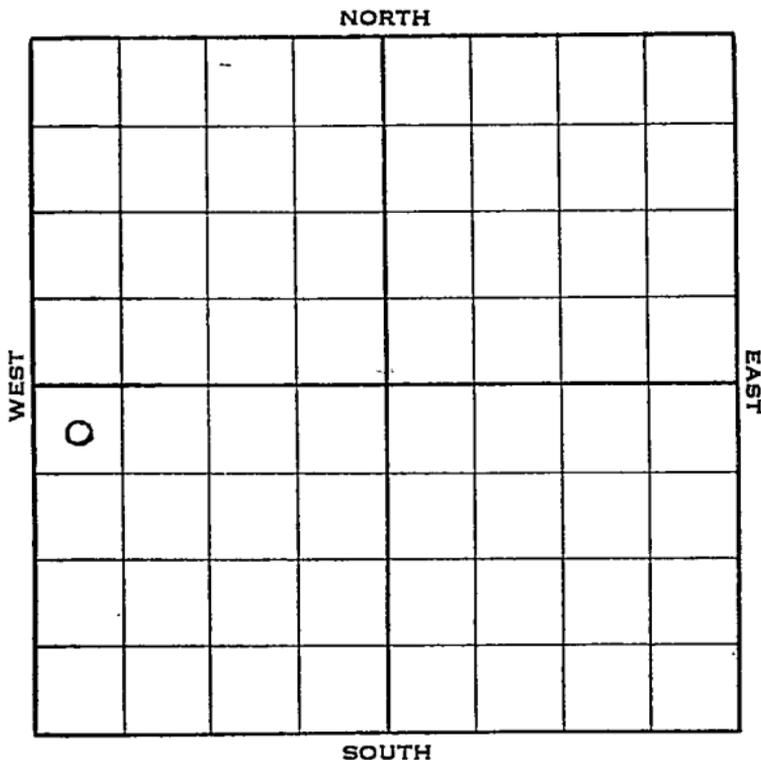

KANSAS

Ellis

Sec. 23 Twp. 11 R. 17-W

Well No. #1 Rumsey Farm

Cities Service Oil Company


260 Ft. from N. Line

_____ Ft. from S. Line

_____ Ft. from E. Line

330 Ft. from W. Line

Elev. 1889

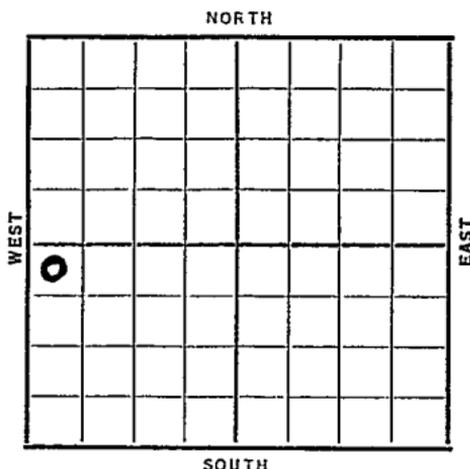

Date	REPORT
1938	
2/16	Location
2/26	B.R.R.
3/4	R. R.
3/11	15" @ 72'. Anhy 1100'.
	10" @ 1110'. WOC.
3/18	Drlg. 2519'.
3/25	Drlg. 3357'.
4/1	Arb. 3366'. 7" @ 3366' T.D. Sm. S.O. RUST.
4/8	T.D. 3373'. 3000' oil 3 hrs.
4/13	7" @ 3366'.
	Arb. 3366'.
	T.D. 3373'.
	Potential 2046 bbls. Nat'l.
	COMPLETED

Ellis KANSAS

Map No. _____ Sec. 23 Twp. 11 R. 17WWell No. 1 RumseyCities Service Oil Company

Contractor _____

FIRST REPORT

NW SW

260 Ft. from N. Line

_____ Ft. from S. Line

_____ Ft. from E. Line

330 Ft. from W. Line

SECTION PLAT

0			

Location X

Rig up _____

Drilling and Remarks:

RECORD

Cased _____ in., _____ ft.

Sand _____

Gas _____

Oil _____

Total Depth _____

PRODUCTION

1st 24 hrs. Nat. _____

1st 24 hrs. after shot _____

Gas _____ Cu. Ft.

Dry Hole _____

Abandoned _____

Date

FEB 16 1938

19

H. D. Hatfield Scout

Map No. 71 Sec. 23 Twp. 11 R. 17W

Well No. 1 Rumsey

Cities Service Oil Company

Contractor

COMPLETED

NW SW

260 Ft. from N. Line

_____ Ft. from S. Line

_____ Ft. from E. Line

330 Ft. from W. Line

SECTION PLAT

0			

Location _____

Rig up _____

Drilling and Remarks:

POT
2046
NOT

RECORD

Cased 7 in. 3366 ft.

Sand Arb 3366

Gas _____

Oil _____

Total Depth 3373

PRODUCTION

1st 24 hrs. Nat. _____

1st 24 hrs. after shot _____

Gas _____ Cu. Ft.

Dry Hole _____

Abandoned _____

Date

APR 13 1938

19

H. D. Hatfield

Scout