


Section 23 Township 11 Range 17-W

Well No. 3 Rumsey

Company Shell

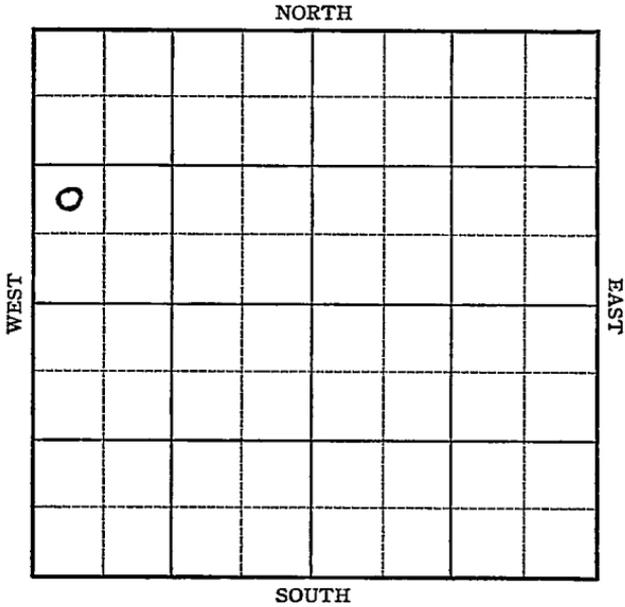

KANSAS

Ellis

Sec. 23 Twp. 11 R. 17


Well No. #3 Ramsey Farm
Shell Company

_____ Ft. from N. Line

990 Ft. from S. Line

_____ Ft. from E. Line

330 Ft. from W. Line

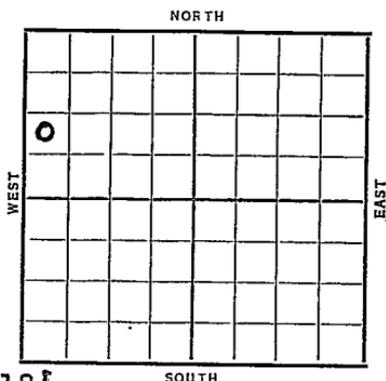

Elev. 1918'

Date

REPORT

1938

1/12 R. R.

1/20 15"-208' Anhy 1128'

10"-1118'

WOC

1/28 Drlg. 2765'

2/4 Arb. ~~3396~~ ³³⁹⁶ T.D. 3400'

Rng. 7" No shows Reported

2/11 Arb. 3396' (Corrected)

T.D. 3422', 7" @ 3398'

2900' oil.

2/16 7" @ 3398'

Arb. 3396'

T.D. 3422'

Potential 2331 bbls., Nat.

COMPLETED

Ellis KANSAS

Map No. 71 Sec. 23 Twp. 11 R17WWell No. 3 RumseyShell Company

Contractor

FIRST REPORT

SECTION PLAT

NW SW NW

 Ft. from N. Line990 Ft. from S. Line Ft. from E. Line330 Ft. from W. Line

0			

Location Rig up

Drilling and Remarks:

RR

RECORD

Cased in., ft.Sand Gas Oil Total Depth

PRODUCTION

1st 24 hrs. Nat. 1st 24 hrs. after shot Gas Cu. Ft.Dry Hole Abandoned

Date

JAN 12 1938 19

E. D. Hatfield Scout

Ellis KANSAS

Map No. _____ Sec. 23 Twp. 11 R. 17WWell No. 3 RumseyShell Company

Contractor _____

COMPLETED

NW SW NW

SECTION PLAT

0			

_____ Ft. from N. Line

990 Ft. from S. Line

_____ Ft. from E. Line

330 Ft. from W. Line

Location _____

Rig up _____

Drilling and Remarks:

ROT
2331
NAT

RECORDCased 7 in. 3398 ft.~~Sand~~ A-6 3396

Gas _____

Oil _____

Total Depth 3422**PRODUCTION**

1st 24 hrs. Nat. _____

1st 24 hrs. after shot _____

Gas _____ Cu. Ft.

Dry Hole _____

Abandoned _____

Date

FEB 16 1938

19

H. D. Hatfield

Scout