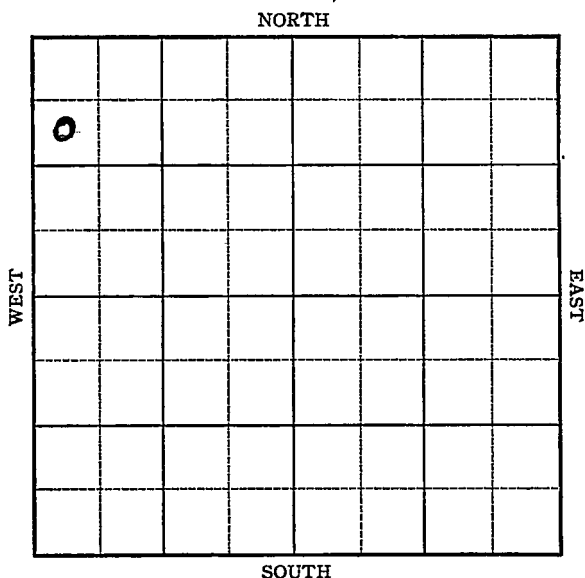


Ellis
O.W.W.O.

KANSAS


Section 23 Township 11 Range 17-WWell No. 2 RumseyCompany Shell

Sec. 23 Twp. 11 R. 17-WWell No. #2 Rumsey FarmShell

Company

990 Ft. from N. Line Ft. from S. Line Ft. from E. Line330 Ft. from W. Line

Elev. 1911

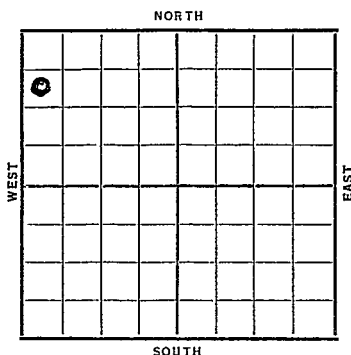

Date

REPORT

1937

12/15 B.R.R.

12/24 15" @ 196'. Drlg. 640'.

12/31 10" @ 1160'. Drlg. 1840'.

1938

1/7 Anhy 1112'. 10" @ 1125'.

Drlg. 2900'.

1/14 Topeka 2805'. Lans. 3135'.

Simp. 3362'. Arb. 3393'.

Cored 3384-97' T.D.

Recovered 3' good saturation.

7" @ 3394'. RUST.

1/19 7" @ 3394'.

Arb. 3393'.

T.D. 3418'.

Potential 2030 bbls. Nat.

COMPLETED

(over)

1956

O.W.W.O.

3-14 OTD 3418
7" @ 3394
DD 3439
5" @ 3438/75
DD 3444
B/ 10 go 12 gwph, 10 hrs., 1000 A
S/ 14 bo, 135 bw 6 hrs.
P/ 16 bo, 179 bw 6 hrs.
Comp. 64 bopd, 748 bw
Tp. 2805
L. 3135
S. 3362
A. 3393

COMPLETED

O.W.W.O.

ONWO

FORM 513 REV. SUNRAY

County Ellis Elev. 1911
 Sec. 23 Twp. 11 Rge. 17W
 Company Shell Oil
 Farm Name Rumsey No. 2

Co.

Lse.

No.

Sec.

T.

R.

TOPS	DEPTH	LOG	DATUM
Anh.			
Tp.	2805		
H.			
Tr.			
Dg.			
BL.			
L.	3135		
K.C.			
B.K.C.			
Ce.			
C.			
M.			
M.			
K.			
Mz.			
Me.			
V.			
S.	3362		
S.			
A.	3393		
R.			
Pe.			
G.			
T.D.			

 Loc. in Sec. SW NW NW

Geol. _____

Contr. _____

 Pool Bemis-Shutts

0		

 FIRST REPORT
 MAR 29 1956
 COMPLETE

Date Comm.

MAR 14 1956

OTD 3418 7" @ 3394 DD 3439

5" @ 3438/75 DD 3444 B/ 10 go 12 gwph

10 hr. 1000 A S/ 14 bo 135 bw 6 hr.

P/ 16 bo. 179 bw 6 hr.

Comp. 64 bopd 748 bw

Ellis KANSAS

Map No. 71 Sec. 23 Twp. 11 R. 17WWell No. 2 RumseyShell Company

Contractor

FIRST REPORT

SW NW NW

990 Ft. from N. Line Ft. from S. Line Ft. from E. Line330 Ft. from W. Line

SECTION PLAT

0			

Location Rig up

Drilling and Remarks:

BRR

RECORD

Cased in., ft.Sand Gas Oil Total Depth

PRODUCTION

1st 24 hrs. Nat. 1st 24 hrs. after shot Gas Cu. Ft.Dry Hole Abandoned

Date

DEC 15 1937 19 H. D. Hatfield Scout

Ellis KANSASMap No. 71 Sec. 23 Twp. 11 R. 17WWell No. 2 RumseyShe 11

Company

Contractor

COMPLETED

SW NW NW

990 Ft. from N. Line Ft. from S. Line Ft. from E. Line330 Ft. from W. Line**SECTION PLAT**

6			

Location Rig up

Drilling and Remarks:

*Pot 2030
 Nat,*

RECORDCased 7 in., 3394 ft.Sand Arb 3393Gas Oil Total Depth 3418**PRODUCTION**1st 24 hrs. Nat. 1st 24 hrs. after shot Gas Cu. Ft.Dry Hole Abandoned

Date

JAN 19 1938

19

H. D. Hatfield Scout