

KANSAS

Ellis


FORM 51 5M 2-38 TPCO.

" "

Section 23 Township 11 Range 17-W

Well No. #3 Rumsey


Company Murphy Oil

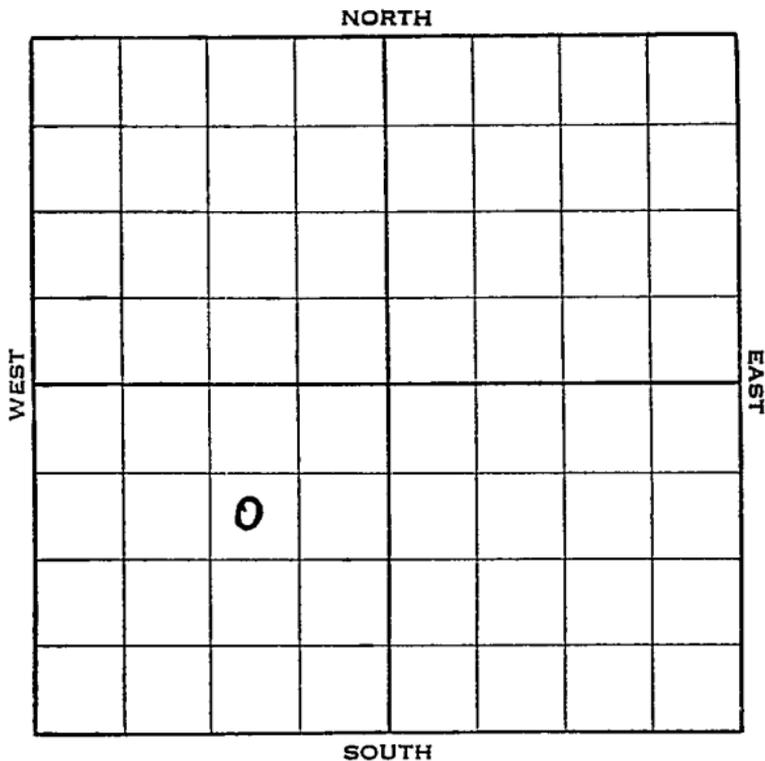

Sec. 23 Twp. 11 R. 17-W

Well No. #3-Rumsey Farm
Murphy Oil Company

990 Ft. from N. Line
 _____ Ft. from S. Line
990 Ft. from E. Line
 _____ Ft. from W. Line

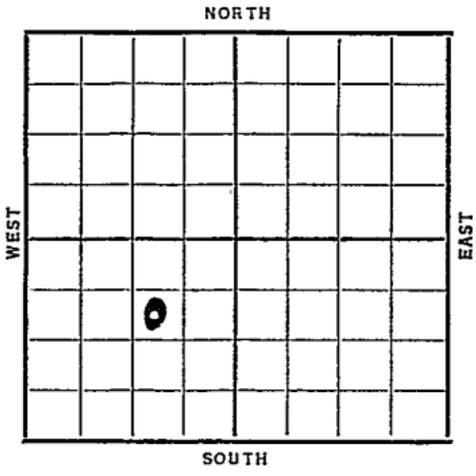

Date	REPORT
1938	
10/19	R.R.
10/28	R. R.
11/4	"
11/12	"
11/18	"
11/25	R U R
12/2	15" - 56' . Fsg. 145'.
12/9	Anh. 1114' . 10" - 1119' . Drlg. 1350' .
12/15	T. D. 2715' fsg.
12/23	TD 2715' SD.
12/30	" "
1939	
1/6	" "
1/13	Drlg. 3255' .
1/20	Arb. 3387' T.D. S. O. Fsg. 7" .
1/27	7" - 3387' . T.D. 3388' . RUST.
	OVER

1939

2/1 7" - 3387'.

Arb. 3387'.

T. D. 3395'.

Potential 83,360 bbls. derived
by echo-meter.

State only allows 3500 bbls. as
maximum potential.

COMPLETED

Ellis KANSAS

Map No. _____ Sec. 23 Twp. 11 R. 17W

Well No. 3 Rumsey

Murphy Oil Company

Contractor

FIRST REPORT

SECTION PLAT

SW NE SW

990 Ft. from N. Line

_____ Ft. from S. Line

990 Ft. from E. Line

_____ Ft. from W. Line

	0		

Location _____

Rig up _____

Drilling and Remarks:

RR

RECORD

Cased _____ in., _____ ft.

Sand _____

Gas _____

Oil _____

Total Depth _____

PRODUCTION

1st 24 hrs. Nat. _____

1st 24 hrs. after shot _____

Gas _____ Cu. Ft.

Dry Hole _____

Abandoned _____

Date

OCT 19 1938 19

H. D. Hatfield Scout

Ellis KANSAS

Map No. _____ Sec. 23 Twp. 11 R. 17WWell No. 3 RumseyMurphy Oil Company

Contractor _____

COMPLETED

SECTION PLAT

SW NE SW
990 Ft. from N. Line
 _____ Ft. from S. Line
990 Ft. from E. Line
 _____ Ft. from W. Line

BEMIS POOL

Location _____

Rig up _____

Drilling and Remarks:

Pot 83360 bbls
 Derived by Echo-meter

 STaTe^{only} allows
 3500 bbls as
 maximum pot.

RECORD

Cased 7 in., 3387 ft.Sand Arb 3387

Gas _____

Oil _____

Total Depth 3395

PRODUCTION

1st 24 hrs. Nat. _____

1st 24 hrs. after shot _____

Gas _____ Cu. Ft.

Dry Hole _____

Abandoned _____

Date

FEB 1 - 1939 19 H. D. Hatfield Scout

Misc Small Maps
Cards
Tracing
France Map
Scarborough Map
Moody Map
Geological Dept.
Moody Flat Book

Handwritten signatures and initials in cursive script, including 'R.A.H.' and 'J.M.'.