

TYPE

AFFIDAVIT OF COMPLETION FORM

ACO-1 WELL HISTORY

Compt. _____

SIDE ONE

Two (2) copies of this form shall be filed with the Kansas Corporation Commission, 200 Colorado Derby Building, Wichita, Kansas 67202, within thirty (30) days after the completion of a well, regardless of how the well was completed.

Attach separate letter of request if the information is to be held confidential. If confidential, only file one copy. Information on Side One will be of public record and Side Two will then be held confidential.

Applications must be made on dual completion, commingling, salt water disposal, injection and temporarily abandoned wells.

Attach one copy only wireline logs (i.e. electrical log, sonic log, gamma ray neutron log, etc.). (Rules 82-2-105 & 82-2-125) KCC# (316) 263-3238. No Log

LICENSE # 5198 EXPIRATION DATE 6/30/84

OPERATOR A. Scott Ritchie API NO. 15-195-21,190

ADDRESS 125 N. Market, Suite 950 COUNTY Trego

Wichita, Kansas 67202 FIELD _____

** CONTACT PERSON Scott Ritchie PROD. FORMATION N/A

PHONE (316) 267-4375

PURCHASER N/A LEASE McCall "E"

ADDRESS _____ WELL NO. 1

DRILLING CONTRACTOR Murfin Drilling Company WELL LOCATION NW SE SE

ADDRESS 250 N. Water, Suite 300 990 Ft. from South Line and

Wichita, Kansas 67202 990 Ft. from East Line of (EX)
the SE (Qtr.) SEC 2 TWP 11 RGE 23 (W).

PLUGGING CONTRACTOR Same as above

ADDRESS _____

TOTAL DEPTH 3910' PBTD N/A

SPUD DATE 4/11/83 DATE COMPLETED 4/16/83

ELEV: CR 2258' DF _____ KB 2263'

DRILLED WITH (~~CXXX~~) (ROTARY) (~~MX~~) TOOLS.

DOCKET NO. OF DISPOSAL OR REPRESSURING WELL BEING USED TO DISPOSE OF WATER FROM THIS LEASE N/A


Amount of surface pipe set and cemented 224' DV Tool Used? No

THIS AFFIDAVIT APPLIES TO: (Circle ONE) - Oil, Gas, Shut-in Gas, Dry, Disposal, Injection, Temporarily Abandoned, OWWO. Other _____

ALL REQUIREMENTS OF THE STATUTES, RULES AND REGULATIONS PROMULGATED TO REGULATE THE OIL AND GAS INDUSTRY HAVE BEEN FULLY COMPLIED WITH.

WELL PLAT

(Office Use Only)

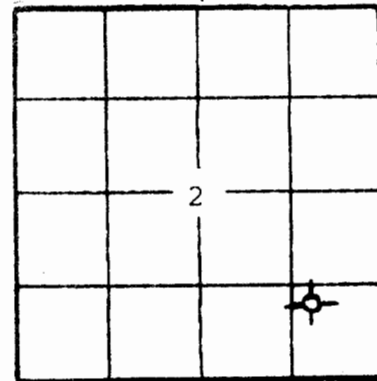

KCC _____
KGS
SWD/REP _____
PLG. _____

A F F I D A V I T

A. Scott Ritchie, being of lawful age, hereby certifies that:

I am the Affiant, and I am familiar with the contents of the foregoing Affidavit. The statements and allegations contained therein are true and correct.

(Signature)

OPERATOR A. Scott Ritchie LEASE McCall "E" SEC. 2 TWP. 11 RGE. 23

FILL IN WELL INFORMATION AS REQUIRED: WELL NO. 1

Show all important zones of porosity and contents thereof; cored intervals, and all drill-stem tests, including depth interval tested, cushion used, time tool open, flowing and shut-in pressures, and recoveries.			SHOW GEOLOGICAL MARKERS, LOGS RUN, OR OTHER DESCRIPTIVE INFORMATION.	
FORMATION DESCRIPTION, CONTENTS, ETC.	TOP	BOTTOM	NAME	DEPTH
<p><input checked="" type="checkbox"/> Check if no Drill Stem Tests Run.</p> <p>No electric logs ran.</p>				
<p>If additional space is needed use Page 2, Side 2</p>				

Report of all strings set— surface, intermediate, production, etc. CASING RECORD (New) or ~~(R&R)~~

Purpose of string	Size hole drilled	Size casing set (in O.D.)	Weight lbs/ft.	Setting depth	Type cement	Sacks	Type and percent additives
Surface	12½"	8-5/8"		224'	common	140	

LINER RECORD			PERFORATION RECORD		
Top, ft.	Bottom, ft.	Sacks cement	Shots per ft.	Size & type	Depth interval
TUBING RECORD					
Size	Setting depth	Pecker set at			