

State of Kansas



JOHN CARLIN
R. C. LOUX
JANE T. ROY
PHILLIP R. DICK
CAROL J. LARSON

Governor
Chairman
Commissioner
Commissioner
Executive Secretary

State Corporation Commission

CONSERVATION DIVISION

(Oil, Gas and Water)
245 North Water
WICHITA, KANSAS 67202

June 27, 1980

JUL 2 1980

WELL PLUGGING AUTHORITY

Dale Hillman Well No. 1
SE SW NE Sec. 18-11S-24W
Trego County
4011'
Warrior Drilling


Rupe Oil Company, Inc.
Box 2273
Wichita, Kansas

Gentlemen:

This is your authority to plug the above subject well in accordance with the Rules and Regulations of the State Corporation Commission.

This authority is void after ninety (90) day from the above date.


Yours very truly,

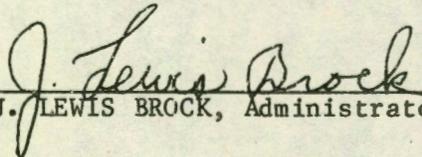
J. LEWIS BROCK, Administrator

Gilbert Balthazor, P.O. Box 9, Palco, Kansas 67657
is hereby assigned to supervise the plugging of the above named well

WELL PLUGGING RECORD

Give All Information Completely
Make Required Affidavit
Mail or Deliver Report to:
Conservation Division
State Corporation Commission
P. O. Box 17027
Wichita, Kansas 67217
NORTH

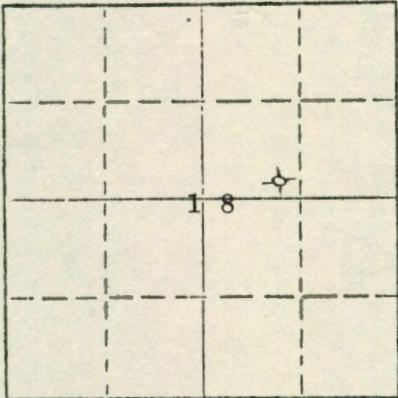

Locate well correctly on above
Section Plat

Trego County, Sec. 18 Twp. 11S Rge. (E) 24W (W)
Location as "NE/CNWxSWx" or footage from lines SE SW NE
Lease Owner Rupe Oil Company, Inc.
Lease Name Dale Hillman Well No. #1
Office Address P. O. Box 2273, Wichita, Kansas 67201
Character of Well (completed as Oil, Gas or Dry Hole) Dry hole
Date well completed June 17, 1980 19
Application for plugging filed June 17, 1980 19
Application for plugging approved June 17, 1980 19
Plugging commenced June 17, 1980 19
Plugging completed June 17, 1980 19
Reason for abandonment of well or producing formation dry hole

If a producing well is abandoned, date of last production 19
Was permission obtained from the Conservation Division or its agents before plugging was commenced? Yes

Name of Conservation Agent who supervised plugging of this well Gilbert Balthazor
Producing formation _____ Depth to top _____ Bottom _____ Total Depth of Well 4011' Feet
Show depth and thickness of all water, oil and gas formations.

OIL, GAS OR WATER RECORDS

CASING RECORD

FORMATION	CONTENT	FROM	TO	SIZE	PUT IN	PULLED OUT
				8 5/8"	253'	-0-

Describe in detail the manner in which the well was plugged, indicating where the mud fluid was placed and the method or methods used in introducing it into the hole. If cement or other plugs were used, state the character of same and depth placed, from _____ feet to _____ feet for each plug set.

Plugged through drill pipe @ 900' w/60 sx. cement
Plugged through drill pipe @ 240' w/30 sx. cement
Plugged through drill pipe @ 40' w/10 sx. cement
and 5 sx. in rathole.

(If additional description is necessary, use BACK of this sheet)

Name of Plugging Contractor Warrior Drilling, Inc.
Address 905 Century Plaza, Wichita, Kansas 67202

STATE OF KANSAS, COUNTY OF SEDGWICK, ss.
Bill G. Lahar (employee of owner) or (owner or operator) of the above-described well, being first duly sworn on oath, says: That I have knowledge of the facts, statements, and matters herein contained and the log of the above-described well as filed and that the same are true and correct. So help me God.

(Signature) Bill G. Lahar
905 Century Plaza, Wichita, Ks. 67202
(Address)

SUBSCRIBED AND SWORN TO before me this 2nd day of July, 19 80

Marilyn Sinard
Marilyn Sinard Notary Public.

My commission expires _____

MARILYN SINARD
STATE NOTARY PUBLIC
SEDGWICK COUNTY, KANSAS
MY APPT. EXP. 4-30-83