

LAUGHLIN-SIMMONS & CO. OF KANSAS, INC.

OIL FIELD SURVEYING  
1337 NORTH MERIDIAN, SUITE 2 (316) 943-5351  
WICHITA, KANSAS 67203

KW3038220

INVOICE NO.

RUPE OIL COMPANY

OPERATOR

2

NO.

Garrett

FARM

Trego

COUNTY

8

S

11s

T


24w

R

SW NW NW

LOCATION

ELEVATION: 2319 Gr.

 

Rupe Oil Company, Inc.  
P.O. Box 2273  
Wichita, Kansas 67201

COPY


MAR 8 1960

AUTHORIZED BY: Bill Clement

PHONE #

routine

SCALE: 2" = 1 MILE

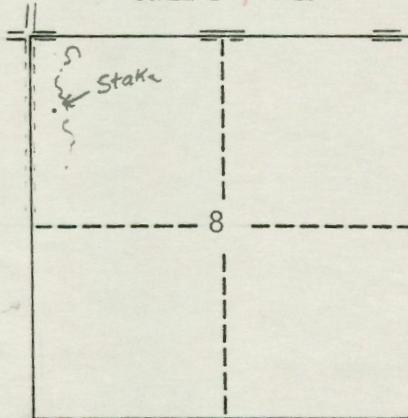

5' & 1' wood stakes  
Slight slope wheat  
& 70' W track & road  
W track at creek

FLAG - west.

3-4-60

DATE

SF

TOTAL

\$120.00

6.01

Handwritten notes in blue ink: "Handwritten checked up Copy 6/11/60"

