


Section 24 Township 11 Range 7W

Well No. #1 Eckart

Company Dickey Oil

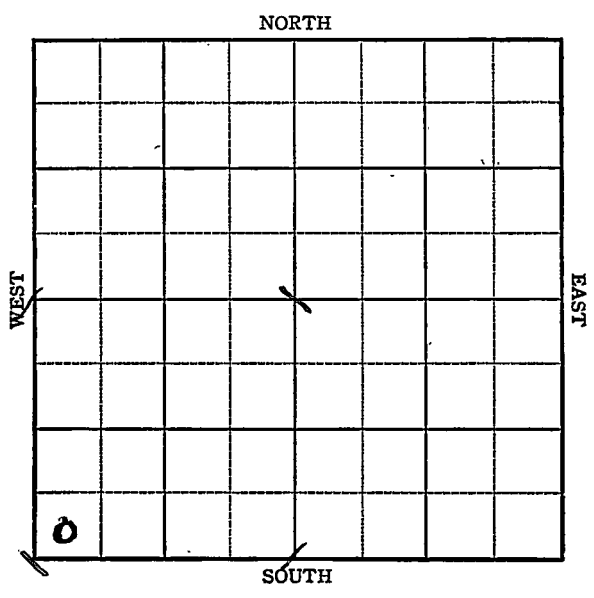

Sec. 24 Twp. 11 R. 7-W

Well No. #1 Eckart Farm


Dickey Oil Company

_____ Ft. from N. Line

330 Ft. from S. Line

_____ Ft. from E. Line

330 Ft. from W. Line

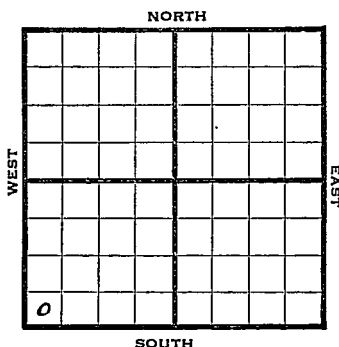

Wildcat

1944

REPORT

3/15	Rotary
3/22	"
3/29	Surface hole
4/5	10" @ 350 Drlg. 2100'
4/12	Drlg. 3140
4/19	Miss 3392 Hunton 3665 Drlg. 3667
4/26	Rigging up
5/3	Arb 4081 TD 4144 No shows.

ABANDON

KANSAS

Pool Name WildcatMap No. 53 Sec. 24 Twp. 11 R. 7WWell No. 1 EckartDickey Oil

Company

ABANDONED

Contractor

SW/C

SECTION PLAT

_____ Ft. from N. Line

330 Ft. from S. Line

_____ Ft. from E. Line

330 Ft. from W. Line

Lincoln County

Location _____

Rig up _____

Drilling and Remarks:

*See #4087**Noe lower*

RECORD

Cased _____ in., _____ ft.

Sand _____

Gas _____

Oil _____

Total Depth 4144

PRODUCTION

1st 24 hrs. Nat. _____

1st 24 hrs. after shot _____

Gas _____ Cu. Ft.

Dry Hole _____

Abandoned _____

Date

MAY 3 1944 19S. J. LEWIS Scout