

KANSAS

Section 24 Township 11 Range 18W

Well No. #18 Marshall "E"

Company Lario Oil & Gas

NORTH

WEST

EAST

SOUTH

16

⑤

Sec. 24 Twp. 11 R. 18W

Well No. #18 Marshall "E" Farm

Lario Oil & Gas Company
Burnett


 Ft. from N. Line

330 Ft. from S. Line

990 Ft. from E. Line

 Ft. from W. Line

SW SE SE

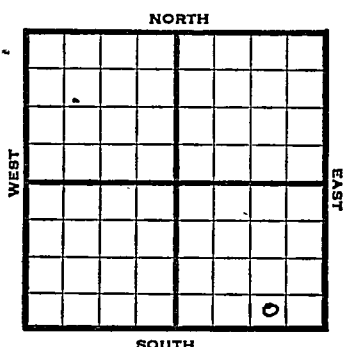

1948 Elev. 1953' REPORT

1/14	Location
1/21	8" @ 1202'
1/26	Drlg 2908'
2/4	Arbuckle 3453'
	TD 3542'
	5" @ 3542'
	RUST
2/11	67 shots 3455-74' - 500 acid
	Swb. 38 bbls. oil 2 hrs.
2/18	"
2/25	Topeka 2906'
	Heebner 3131'
	Lansing 3181'
	Simpson 3446'
3/3	"
3/10	"
3/17	"
3/24	"
3/31	"
4/7	"
4/14	"

OVER

1948

4/21 Arbuckle 3453'
5" @ 3542'
Perf.
500 Acid
Pump 227 Pot.
Gr. 36°
TD 3542'

COMPLETED

Map No. _____ Sec. 24 Twp. 11 R. 18W

Well No. 18 Marshall "E"

Lario Oil & Gas Company

FIRST REPORT

Contractor _____

SW SE SE

SECTION PLAT

_____ Ft. from N. Line

330 Ft. from S. Line

.990 Ft. from E. Line

_____ Ft. from W. Line

Ellis County

Location X

Rig up _____

Drilling and Remarks:

RECORD

Cased _____ in, _____ ft.

Sand _____

Gas _____

Oil _____

Total Depth _____

PRODUCTION

1st 24 hrs. Nat. _____

1st 24 hrs. after shot _____

Gas _____ Cu. Ft.

Dry Hole _____

Abandoned _____

Date

JAN 14 1948 19 S I I FWIS Scout

Misc. Small-Maps

Cards

Tracing

France Map

Scarborough Map

Pierce Map

Geological Dept.

Pierce Plat Book

Map No. 71 Sec. 24 Twp. 11 R. 18W

Well No. 18 Marshall "E"

Lario Oil & Gas Company

COMPLETE

Contractor

SW SE SE

E1/953

SECTION PLAT

 Ft. from N. Line

330 Ft. from S. Line

990 Ft. from E. Line

 Ft. from W. Line

6

Ellis County

Location

Rig up

Drilling and Remarks:

Cor 83453

5" @ 3542

Perf.

500 Acid C

Pump 227 B & X

360 lbs

RECORD

Cased in., ft.

Sand

Gas

Oil

Total Depth 3542

PRODUCTION

1st 24 hrs. Nat.

1st 24 hrs. after shot

Gas Cu. Ft.

Dry Hole

Abandoned

Date

APR 21 1948

19

S. J. LEWIS

Scout












Misc. Small Maps	
Cards	
Tracing	
France Map	
Scarborough Map	
Piercé Map	
Geological Dept.	
Post Box	


