KANSAS

Ellis


FORM 51 IOM 12-46 PETROL

Section 24 Township 11 Range 18-W

Well No. 3 Peavey "B"

Company Sunray

Burnett Pool

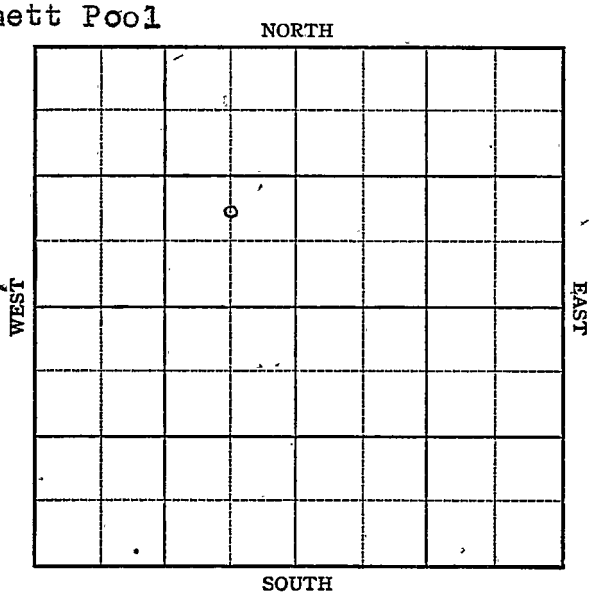

6

FORM 252-A
5M 12-46 PETROL

KANSAS

Ellis

Sec. 24 Twp. 11 R. 18W

Well No. 3 Peavey "B" Farm

Sunray Company

Burnett Pool


_____ Ft. from N. Line

990 Ft. from S. Line

660 Ft. from E. Line

_____ Ft. from W. Line

C N L SE NW

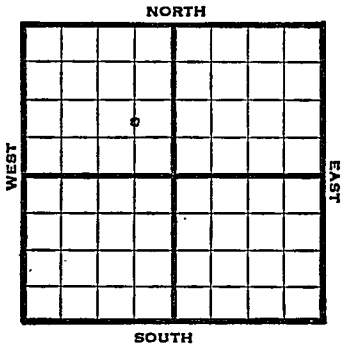

1947	Elev. 1993' REPORT
8/13	Loc.
8/20	RUR
8/27	8" @ 1240' Drlg. 2215'
9/3	Arbuckle 3494 TD 3501 5" @ 349 0 Rust
9/10	TD 3508' CO
9/17	Arb. 3494' 5" @ 3498' 1000 Acid Pump 705 Pot Gr. 37° Total Depth 3508' COMPLETED

Form 26 200 Bks. 10-46 Petrol

Kansas

Burnett Pool

Map No. _____ Sec. 24 Twp. 11 R. 18W


Well No. 3 Peavey "B"

Sunray Company

FIRST REPORT Contractor

C N L SE NW

SECTION PLAT

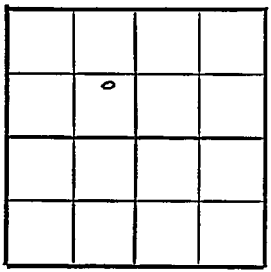

_____ Ft. from N. Line

990 Ft. from S. Line

660 Ft. from E. Line

_____ Ft. from W. Line

Ellis County

Location X

Rig up _____

Drilling and Remarks:

RECORD

Cased _____ in., _____ ft.

Sand _____

Gas _____

Oil _____

Total Depth _____

PRODUCTION

1st 24 hrs. Nat. _____

1st 24 hrs. after shot _____

Gas _____ Cu. Ft.

Dry Hole _____

Abandoned _____

Date

AUG 13 1947 19 S. J. LEWIS Scout

Form 26 200 Bks. 10-46 Petrol

Burnett Pool

Kansas

Map No. 71 Sec. 24 Twp. 11 R. 18W

Well No. 3 Peavey "B"


Sunray Company

COMPLETE Contractor

C N L SE NW

E.L. 1983

SECTION PLAT

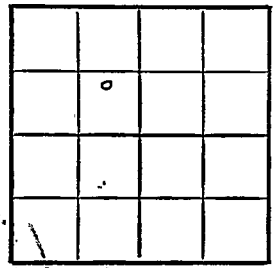

____ Ft. from N. Line

990 Ft. from S. Line

660 Ft. from E. Line

____ Ft. from W. Line

Ellis County

Location

Rig up

Drilling and Remarks:

Cut 3494

5" @ 3498

1000 acid

Pump 705 Bbl

87 6 Gr

RECORD

Cased ____ in., ____ ft.

Sand

Gas

Oil

Total Depth 3508

PRODUCTION

1st 24 hrs. Nat.

1st 24 hrs. after shot

Gas ____ Cu. Ft.

Dry Hole

Abandoned

Date

SEP 17 1947 19

S. J. LEWIS Scout