


Section 24 Township 11 Range 18-W

Well No. #4 Peavey (C)

Company Sunray

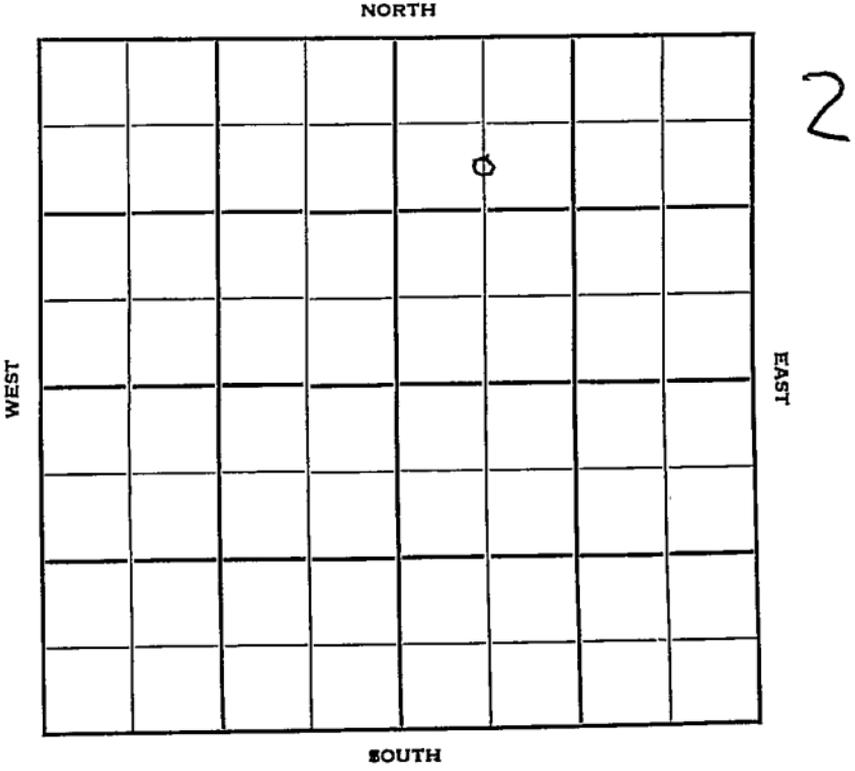

Sec. 24 Twp. 11 R. 18W

Well No. #4 Peavey (C) Farm

Sunray Company

Contractor

Bemis


990' Ft. from N. Line

Ft. from S. Line

Ft. from E. Line

660' Ft. from W. Line

C S/2 NW NE

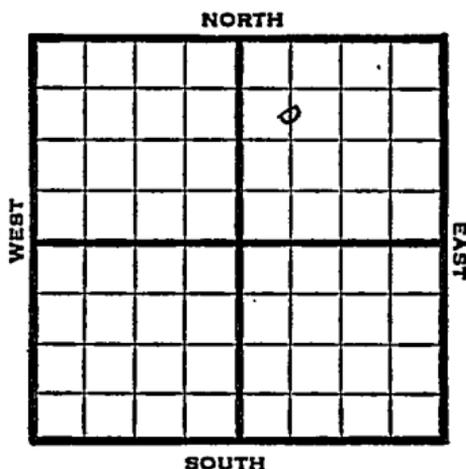

1950

Elev. 1957' REPORT

5/17

Spud 5-15-50

Drlg. 642'

5/31

8-5/8" @ 1150'

Heeb 3138'

KC 3176'

Arb 3493'

DST 3497-3511

Rec. salt wtr

TD 3511'

D&A

**ABANDONED**

Kansas

Map No. \_\_\_\_\_ Sec. 24 Twp. 11 R. 18W

Well No. 4 Peavey (C)

Sunray \_\_\_\_\_ Company

\_\_\_\_\_ Contractor

C S/2 NW NE

## SECTION PLAT

990 Ft. from N. Line

\_\_\_\_\_ Ft. from S. Line

\_\_\_\_\_ Ft. from E. Line

660 Ft. from W. Line

		0	
FIRST REPORT.			

Ellis

Location \_\_\_\_\_

Rig up \_\_\_\_\_

## Drilling and Remarks:

Spud 5-15-50

Drlg. 642

## RECORD

Cased \_\_\_\_\_ in., \_\_\_\_\_ ft.

Sand \_\_\_\_\_

Gas \_\_\_\_\_

Oil \_\_\_\_\_

Total Depth \_\_\_\_\_

## PRODUCTION

1st 24 hrs. Nat. \_\_\_\_\_

1st 24 hrs. after shot \_\_\_\_\_

Gas \_\_\_\_\_ Cu. Ft.

Dry Hole \_\_\_\_\_

Abandoned \_\_\_\_\_

Date

MAY 17 1950

19

J. E. TYRA Scout

Bemis

Form 26 200 Bks. 11-49 Petrol Kansas

Map No. \_\_\_\_\_ Sec. 24 \_\_\_\_\_ Twp. 11 \_\_\_\_\_ R. 18W

Well No. 4 Peavey (C)

Sunray \_\_\_\_\_ Company

C S/2 NW NE \_\_\_\_\_ Contractor


E. 1957  
SECTION PLAT

990 \_\_\_\_\_ Ft. from N. Line

\_\_\_\_\_ Ft. from S. Line

\_\_\_\_\_ Ft. from E. Line

660 \_\_\_\_\_ Ft. from W. Line

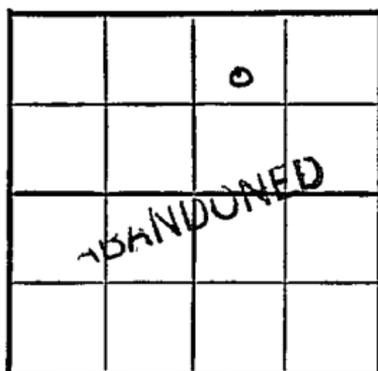

Ellis

Location \_\_\_\_\_

Rig up \_\_\_\_\_

Drilling and Remarks:

8 7/8" C 1150  
 Heel. 3138  
 KC. 3176  
 Arb. 3493  
 DST 3497-3511  
 Rec. salt water  
 D+A

## RECORD

Cased \_\_\_\_\_ in., \_\_\_\_\_ ft.

Sand \_\_\_\_\_

Gas \_\_\_\_\_

Oil \_\_\_\_\_

Total Depth 3511

## PRODUCTION

1st 24 hrs. Nat. \_\_\_\_\_

1st 24 hrs. after shot \_\_\_\_\_

Gas \_\_\_\_\_ Cu. Ft.

Dry Hole \_\_\_\_\_

Abandoned \_\_\_\_\_

Date

MAY 31 1950 19

J. E. TYRA Scout