

KANSAS


Form 51-5M-7-40-Palace

Ellis

Section 24 Township 11 Range 18-W

Well No. #2 Peavey "C"

Company Darby Oil

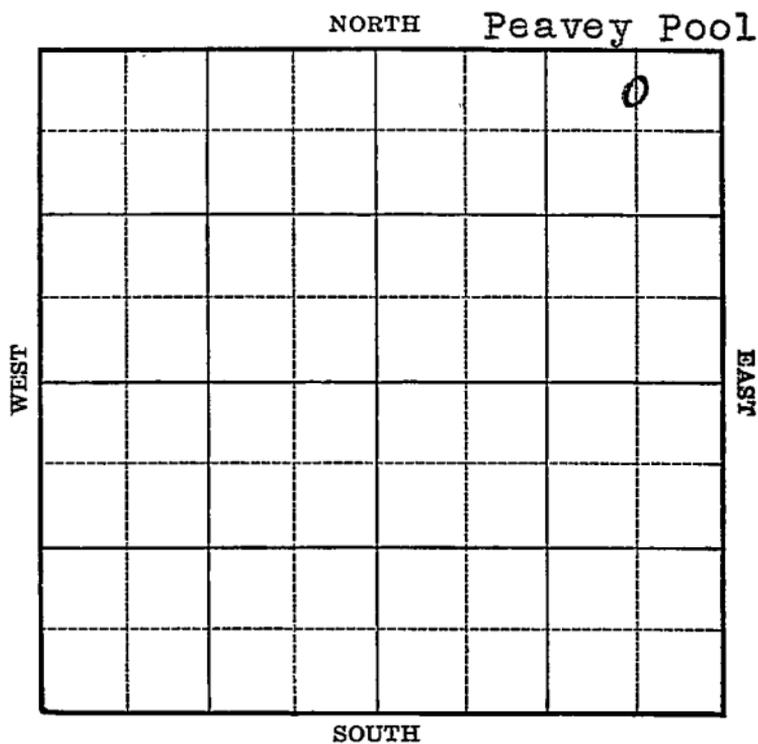

1940

11/26

Arb. 3406'

7" - 3406'

T.D. 3458'

Shot 20 qts. 3426-49'

4000 acid.

Potential 852 bbls., pump.

35. Gravity

COMPLETED

Map No. 71 Sec. 24 Twp. 11 R. 18WWell No. 2 Peavey "C"Darby Oil Company

Contractor

FIRST REPORT
C N L NE NE330 Ft. from N. Line Ft. from S. Line660 Ft. from E. Line Ft. from W. Line

PEAVEY Pool

SECTION PLAT

			o

Location Rig up

Drilling and Remarks:

Derrick

RECORD

Cased in., ft.Sand Gas Oil Total Depth

PRODUCTION

1st 24 hrs. Nat. 1st 24 hrs. after shot Gas Cu. Ft.Dry Hole Abandoned

Date

OCT 2 1940 19S. J. LEWIS Scout

Misc Small Maps	<i>DAV</i>
Cards	<i>DAV</i>
Tracing	<i>DAV</i>
France Map	<i>DAV</i>
Scarborough Map	<i>DAV</i>
Moody Map	<i>DAV</i>
Geological Dept.	
Moody Flat Book	

Map No. 71 Sec. 24 Twp. 11 R. 18W

Well No. 2 Peavey "C"

Darby Petroleum Company

Contractor

COMPLETED

C N L NE NE

330 Ft. from N. Line

_____ Ft. from S. Line

660 Ft. from E. Line

_____ Ft. from W. Line

PEAVEY POOL

SECTION PLAT

			o

Location _____

Rig up _____

Drilling and Remarks:

Cr 83406

7" @ 8406

209 to 3426 - 49

4000 cu. ft.

Pump. 852 P.S.

35.0 G.P.

RECORD

Cased _____ in., _____ ft.

Sand _____

Gas _____

Oil _____

Total Depth 3458

PRODUCTION

1st 24 hrs. Nat. _____

1st 24 hrs. after shot _____

Gas _____ Cu. Ft.

Dry Hole _____

Abandoned _____

Date

NOV 26 1940 19

S. J. LEWIS Scout

Misc Small *RAY*
Cards *Paul*
Tracing *J.P.*
Francis *RAY*
Scarbo *RAY*
Moddy *Joe*
Ge lo
Moddy