

KANSAS


Ellis

FORM 51 5M 10-41 PETROL

Section 24 Township 11 Range 18-W

Well No. #1 Marshall "E"

Company Lario

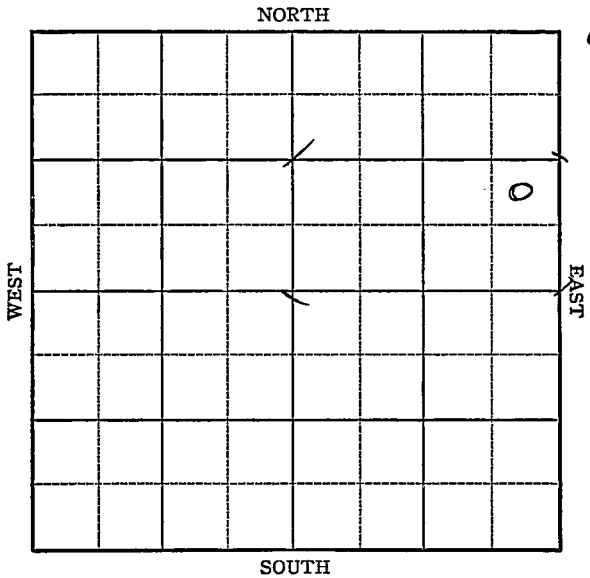

Sec. 24 Twp. 11 R. 18-W

Well No. #1 Marshall "D" Farm

Lario Company

(Walters)


_____ Ft. from N. Line

990 _____ Ft. from S. Line

330 _____ Ft. from E. Line

_____ Ft. from W. Line

Elev. 1884

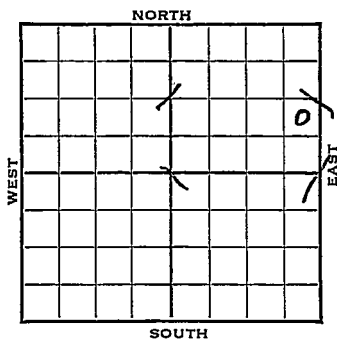

1942

REPORT

7/15 Location
7/22 Material.
7/29 "
8/5 12" - 75' Drlg. 150'
8/12 Drlg 2857'
8/19 Lans. 3080 BKC 3360
Arb. 3378
Drlg. 3460'
8/27 5" @ 3470 TD Rust
9/2 Swb 5 oil per hr 8% water.
9/9 Arb. 3378 5" - 3470
113 shots 3378-3425 $\frac{1}{2}$
4500 acid
T.D. 3470
Pump 15 Pot.
Gravity 35.

COMPLETED

Map No. 71 Sec. 24 Twp. 11 R. 18W

Well No. 1 Marshall "E"

Lario Company

COMPLETED Contractor

NE SE NE

SECTION PLAT

_____ Ft. from N. Line

990 Ft. from S. Line

330 Ft. from E. Line

_____ Ft. from W. Line

			o

RICHARDS POOL

Location _____

Rig up _____

Drilling and Remarks:

Cor & 3378
5" @ 3470
118' hole to 3378-3470 5 1/2"
4500 Acid
Pump. 15 P & X
35-0 Gr

RECORD

Cased _____ in., _____ ft.

Sand _____

Gas _____

Oil _____

Total Depth 3478

PRODUCTION

1st 24 hrs. Nat. _____

1st 24 hrs. after shot _____

Gas _____ Cu. Ft.

Dry Hole _____

Abandoned _____

Date

SEP 9 1942 19

S. J. LEWIS Scout